

KANSAS


Form 51-5M-7-39-Palace

Rice

Section 28 Township 19 Range 10-W

Well No. #6 L. F. Manke

Company Stanolind

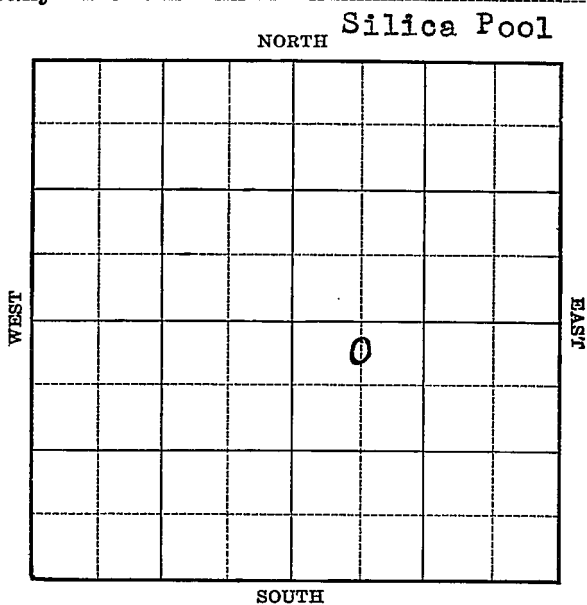

Sec. 28 Twp. 19 R. 10-W

Well No. #6 L. F. Manke Farm _____
Stanolind Company _____

(Silica)


330 Ft. from N. Line

_____ Ft. from S. Line

_____ Ft. from E. Line

660 Ft. from W. Line

Elev. 1768

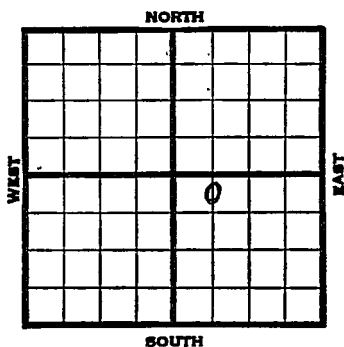

1939	REPORT
10/11	Location
10/19	Rotary.
10/26	10" - 227' Anhy 426'
	Drlg. 1725'
11/2	Lans. 2940' Drlg. 2970'
11/9	2-3/4 M gas 3018-19'
	8 M gas S.O. 3039'
	Drlg. 3043'
11/16	5000 acid. 13 1/2 M gas.
	Drlg. 3072'
11/23	Drlg. 3157'
11/29	Drlg. 3208'
12/7	Drlg. 3233'
12/14	Quartzite 3200' T.D. 3225'
	P. B. to 3185' WOC.
	OVER

1939
12/20

Lans. 2940'
7" - 3009'
Quartzite 3200'
T.D. 3235'
P. B. to 3032'
Drilled to 3043'
5 M cu. ft. gas.

COMPLETED

Map No. 46 Sec. 28 Twp. 19 R. 10WWell No. 6 L. F. MankeStanolind

Company

Contractor

FIRST REPORT

SECTION PLAT

C $N\frac{1}{2}$ NW SE330 Ft. from N. Line Ft. from S. Line Ft. from E. Line660 Ft. from W. Line

		o	

SILICA POOL

Location XRig up

Drilling and Remarks:

RECORD

Cased in., ft.Sand Gas Oil Total Depth

PRODUCTION

1st 24 hrs. Nat. 1st 24 hrs. after shot Gas Cu. Ft.Dry Hole Abandoned

Date

OCT 1 1939

19

S. I. LEWIS

Scout

Map No. 46 Sec. 28 Twp. 19 R. 10WWell No. 6 L. F. MankeStanolind

Company

Contractor

COMPLETED

C $N\frac{1}{2}$ NW SE

SECTION PLAT

330 Ft. from N. Line

_____ Ft. from S. Line

_____ Ft. from E. Line

660 Ft. from W. Line

		o	

SILICA POOL

Location _____

Rig up _____

Drilling and Remarks:

*have 2940
7" @ 3009.
Liner to 3200
P. 33032
Hilled to 3043

511 Gas.*

RECORD

Cased _____ in., _____ ft.

Sand _____

Gas _____

Oil _____

Total Depth 3235

PRODUCTION

1st 24 hrs. Nat. _____

1st 24 hrs. after shot _____

Gas _____ Cu. Ft.

Dry Hole _____

Abandoned _____

Date

DEC 20 1939 19

S. J. LEWIS Scout

*small maps
Paul*

Misc Small Maps

Cards

Tracing

France Map

Scarborough Map

Moody Map

Geological Dept.

Moody Flat Book