


Section 28 Township 19 Range 10-W

Well No. #3 Smith

Company Skelly

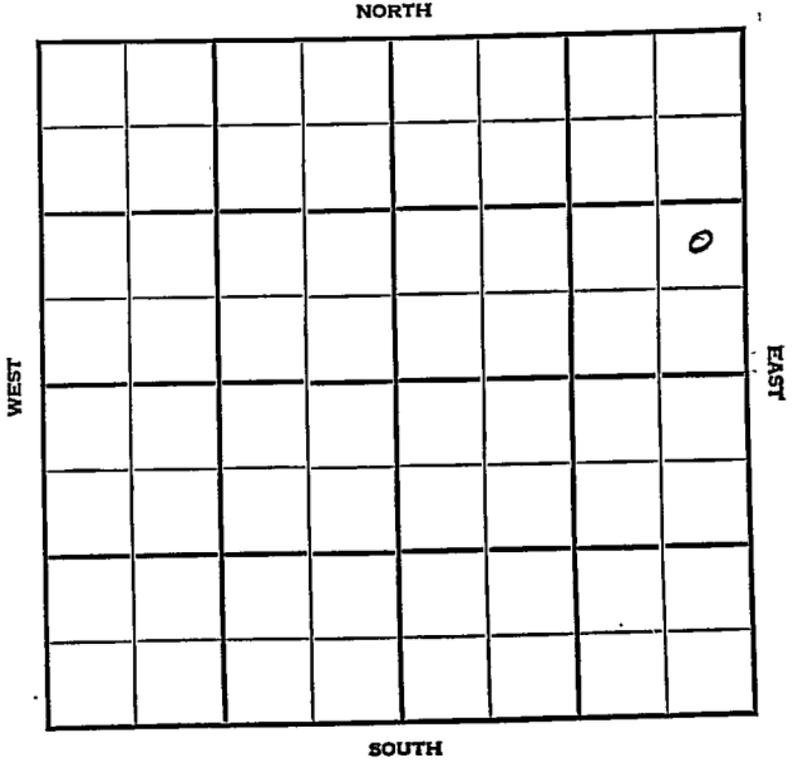



Sec. 28 Twp. 19 R. 10W

Well No. #3 Smith Farm

Skelly Company

Silica


_____ Ft. from N. Line

990 Ft. from S. Line

330 Ft. from E. Line

_____ Ft. from W. Line

NE SE NE

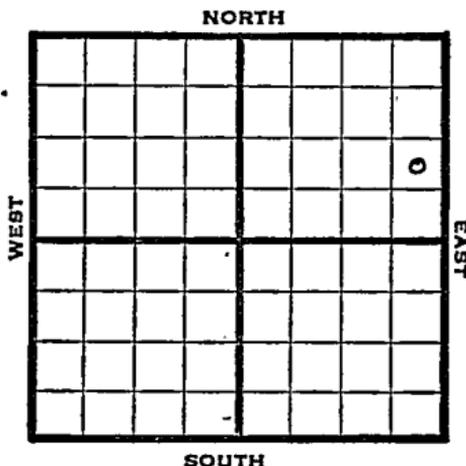

1947	Elev. 1760' REPORT
12/3	Location
12/10	8" @ 219'
	WOC
12/17	Drlg. 2470'
1948	
1/7	Arbuckle 3269'
	5" @ 3270'
	1500 acid
	Pump 70 oil & 19 W Pot.
	Gr. 42°
	Total Depth 3287'
	COMPLETED

Map No. _____ Sec. 28 Twp. 19 R. 10W

Well No. 3 Smith

Skelly Company

FIRST REPORT Contractor

NE SE NE

SECTION PLAT

_____ Ft. from N. Line

990 Ft. from S. Line

330 Ft. from E. Line

_____ Ft. from W. Line

			o

Rice County

Location X

Rig up _____

Drilling and Remarks:

RECORD

Cased _____ in., _____ ft.

Sand _____

Gas _____

Oil _____

Total Depth _____

PRODUCTION

1st 24 hrs. Nat. _____

1st 24 hrs. after shot _____

Gas _____ Cu. Ft.

Dry Hole _____

Abandoned _____

Date

DEC 3 1947 19

S. J. LEWIS Scout

