

KANSAS

Form 51—5M—7-39—Palace


Rice

Section 28 Township 19 Range 9-W

Well No. #2 Purcell "C"

Company Cities Service Oil

NORTH Chase Pool

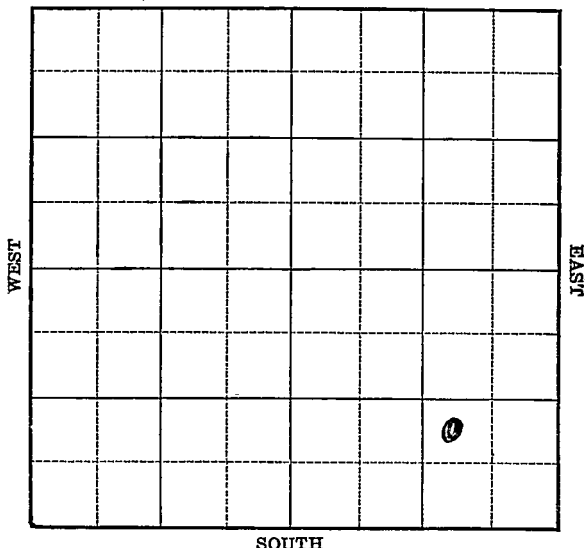

Map No. 49 Sec. 28 Twp. 19 R. 9WWell No. 2 Purcell "C"Cities Service Oil Company

Contractor

FIRST REPORT
NW SE SE

SECTION PLAT

			0

 Ft. from N. Line990 Ft. from S. Line990 Ft. from E. Line Ft. from W. Line

CHASE POOL

Location Rig up

Drilling and Remarks:

Rotary Rig Up

RECORD

Cased in., ft.Sand Gas Oil Total Depth

PRODUCTION

1st 24 hrs. Nat. 1st 24 hrs. after shot Gas Cu. Ft.Dry Hole Abandoned

Date

MAR 20 1940

19

S. J. LEWIS

Scout

Map No. 49 Sec. 28 Twp. 19 R. 9WWell No. 2 Purcell "C"

Cities Service Oil Company

Contractor

COMPLETED

NW SE SE

Ft. from N. Line

990 Ft. from S. Line990 Ft. from E. Line

Ft. from W. Line

SECTION PLAT

			o

CHASE POOL

Location

Rig up

Drilling and Remarks:

2000 acid.Depth. Pot.
1960 bbls.

RECORD

Cased _____ in _____ ft.

Sand Gurburkle 3198

Gas _____

Oil _____

Total Depth 3216

PRODUCTION

1st 24 hrs. Nat. _____

1st 24 hrs. after shot _____

Gas _____ Cu. Ft.

Dry Hole _____

Abandoned _____

Date

APR 10 1940₁₉

S. J. LEWIS Scout