


Rice

KANSAS

Section 28 Township 19 Range 9-W

Well No. 1 J. M. Purcell "B"

Company Cities Service Oil

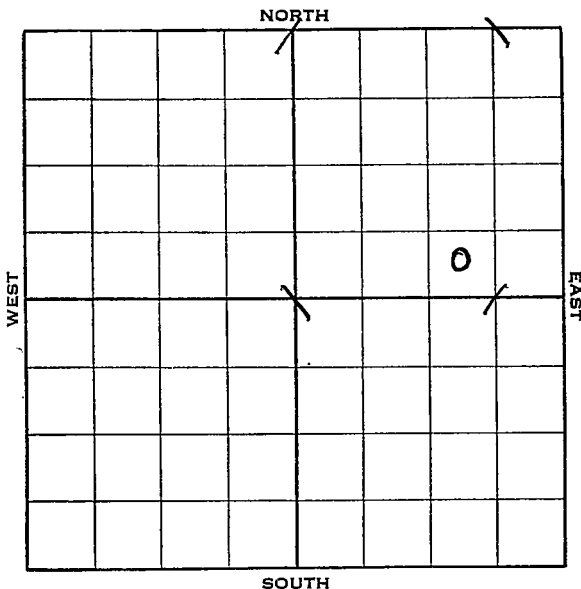

KANSAS Rice

Sec. 28 Twp. 19 R. 9-W

Well No. #1 J. M. Purcell "B" Farm

Cities Service Oil Company


_____ Ft. from N. Line

330 Ft. from S. Line

990 Ft. from E. Line

_____ Ft. from W. Line

Elev. 1692

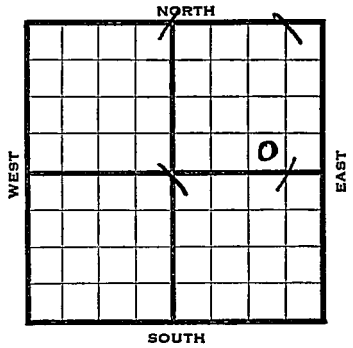

1938	REPORT
4/27	B.R.R.
5/6	10" @ 232'. Drlg. 1405'.
5/12	Dr lg. 3200'.
5/18	Arb. 3231'.
	T.D. 3250'.
	No shows.
	COMPLETED ABANDONED

Rice

KANSAS

Map No. 49 Sec. 28 Twp. 19 R. 9WWell No. 1 J. M. PurcellCities Service Oil Company

Contractor

~~FIRST REPORT~~

SECTION PLAT

SW SE NE

1 Ft. from N. Line330 Ft. from S. Line990 Ft. from E. Line

_____ Ft. from W. Line

Location _____

Rig up _____

Drilling and Remarks:

BRR

RECORD

Cased _____ in., _____ ft.

Sand _____

Gas _____

Oil _____

Total Depth _____

PRODUCTION

1st 24 hrs. Nat. _____

1st 24 hrs. after shot _____

Gas _____ Cu. Ft.

Dry Hole _____

Abandoned _____

Date

APR 27 1938 19

H. D. Hatfield Scout

Rice KANSAS

Map No. 46 Sec. 28 Twp. 19 R. 9^W

Well No. 1-Purcell "B"

Cities Service Company

sw se ne Contractor

CORRECTION

SECTION PLAT

			0

_____ Ft. from N. Line

330 Ft. from S. Line

990 Ft. from E. Line

_____ Ft. from W. Line

Location _____

Rig up _____

Drilling and Remarks:

*first reported
as #1-J.M. Purcell
corrected to
1-Purcell "B"*

RECORD

Cased _____ in., _____ ft.

Sand _____

Gas _____

Oil _____

Total Depth _____

PRODUCTION

1st 24 hrs. Nat. _____

1st 24 hrs. after shot _____

Gas _____ Cu. Ft.

Dry Hole _____

Abandoned _____

Date

MAY 4 - 1938

19

H. D. Hatfield

Scout

Rice

KANSAS

Map No. 49 Sec. 28 Twp. 19 R. 9W

Well No. L. J. M. Purcell "B"

Cities Service Oil Company

Contractor

ABANDONED

SW SE NE

_____ Ft. from N. Line

330 Ft. from S. Line

990 Ft. from E. Line

_____ Ft. from W. Line

SECTION PLAT

Location _____

Rig up _____

Drilling and Remarks:

No shows

D & A

*Production
1st 24 hrs. after shot*

RECORD

Cased _____ in., _____ ft.

Sand Arb 3231

Gas _____

Oil _____

Total Depth 3250

PRODUCTION

1st 24-hrs. Nat. _____

1st 24 hrs. after shot _____

Gas _____ Cu. Ft.

Dry Hole _____

Abandoned _____

Date

MAY 18 1938

19

H. D. Hatfield Scout