


Section 28 Township 19 Range 9W

Well No. #3 Purcell (A)

Company Cities Service Oil

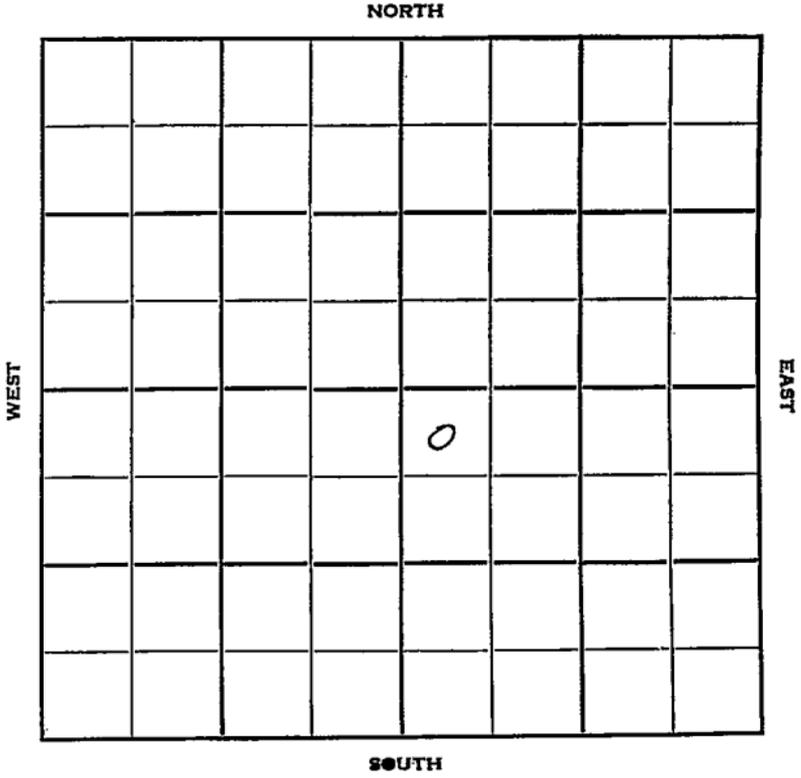

Rice

Sec. 28 Twp. 19 R. KANSAS ^{9W}

Well No. #3 Purcell (A) Farm

Cities Service Oil Company

Contractor


330' Ft. from N. Line

Ft. from S. Line

Ft. from E. Line

330' Ft. from W. Line

NW NW SE

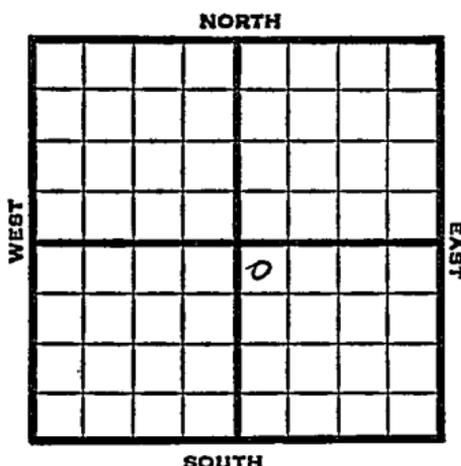

1951 Elev. 1699' REPORT

6/20 Spud 6-14-51
8" @ 220'
Drlg. 1740'

8/1 Spud 6-14-51
Oil Well TD 3332
8" @ 220
Lans. 2886 Arb. 3320
TD 3332 5" @ 3323
2000 A 71 bopd
5000 A F/75 bopd Comp. 165 ho
6 bwpd

COMPLETED

County Rice State Kansas

Sec. 28 (Blk.) 19 (Sur.) 9W Map No.

Operator Cities Service

Well No. 3 Farm Purcell "A"

Elev. 1699 Location NW NW SE

COMPLETE

330 Ft. From N Line SE

330 Ft. From W Line Quarter

Ist. Report

Completion AUG 1 1951

Remarks

Spudding Date 6-14-51

Drlg. Data Oil well TD 3332

8" @ 220 Lans. 2886 Arb. 3320

FD 3332 5" @ 3323 2000 A 71 bopd

5000 A P/ 75 bopd Comp. 165 bo 6 bwpd