


Kanons Rice

Section 28 Township 19 Range 9-W

Well No. #1 Robbins

Company Derby Drlg

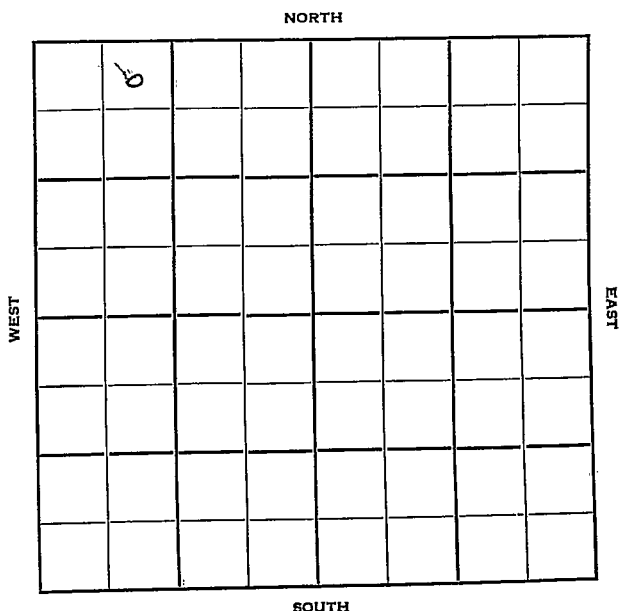

KANSAS

Rice

Sec. 28 Twp. 19 R. 9-W

Well No. #1 Robbins Farm

Derby Drlg Company

Chase Pool


330 Ft. from N. Line

 Ft. from S. Line

 Ft. from E. Line

990 Ft. from W. Line

NE NW NW

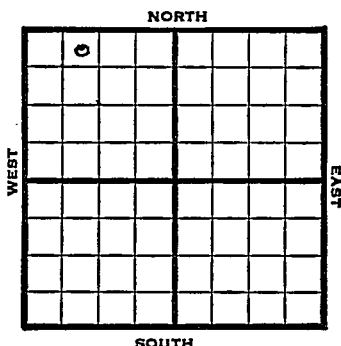

1950

Elev 1716'

REPORT

2/22

Spud 2-21-50

3/22

8" @ 190'

Br Lime 2868'

Lans 2887'

Arb. 3207'

5" @ 3208'

TD 3238'

500 acid

Comp 35 BOPD

Comp

COMPLETED

Map No. _____ Sec. 28 Twp. 19 R. 9WWell No. 1 Robbins

_____ Derby Drlg. _____ Company

_____ Contractor
NE NW NW330 Ft. from N. Line


_____ Ft. from S. Line

_____ Ft. from E. Line

990 Ft. from W. Line

Rice County

SECTION PLAT

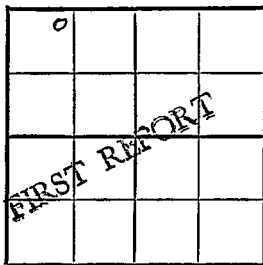

Location _____

Rig up _____

Drilling and Remarks:

Spud 2-21-50

RECORD

Cased _____ in., _____ ft.

Sand _____

Gas _____

Oil _____

Total Depth _____

PRODUCTION

1st 24 hrs. Nat. _____

1st 24 hrs. after shot _____

Gas _____ Cu. Ft.

Dry Hole _____

Abandoned _____

Date

FEB 22 1950 19J. E. TYRA

Scout

Map No. _____ Sec. 28 Twp. 19 R. 9W

Well No. 1 Robbins

Derby Drlg. _____ Company

Contractor

NE NW NW

E-1 1716


SECTION PLAT

330 Ft. from N. Line

_____ Ft. from S. Line

_____ Ft. from E. Line

990 Ft. from W. Line

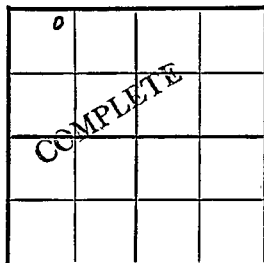

Rice County

Location _____

Rig up _____

Drilling and Remarks:

8" @ 190
 Br. line 2868
 Lans. 2887
 arb. 3207
 5" @ 3208
 T.D. 3238
 500 Acid
 Comp. 35 bpd

RECORD

Cased _____ in., _____ ft.

Sand _____

Gas _____

Oil _____

Total Depth _____

PRODUCTION

1st 24 hrs. Nat. _____

1st 24 hrs. after shot _____

Gas _____ Cu. Ft.

Dry Hole _____

Abandoned _____

Date

MAR 22 1950 19 J. E. TYRA Scout