


Section 28 Township 19 Range 9 WWell No. # 2 Purcell "A"Company Dozier Oil

NORTH

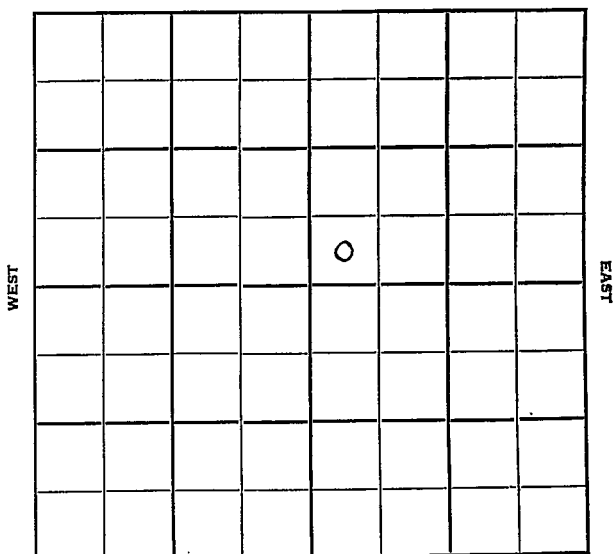

SOUTH

Rice

KANSAS

Sec. 28 Twp. 19 R. 9 W 1

Well No. # 2 Purcell 1A Farm

Dozier Oil Company

Lewis Drlg. Contractor

Chase Pool


Ft. from N. Line

330 Ft. from S. Line

Ft. from E. Line

330 Ft. from W. Line

SW SW NE

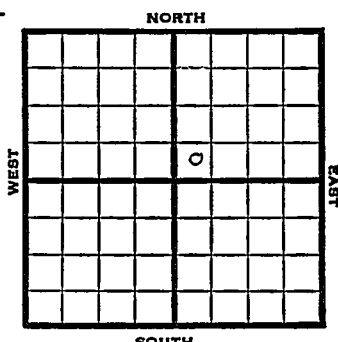

1951

Elev. 1699' REPORT

5/2

Spud 4-26-51

8" @ 203'

Drlg. 1925'

6/13

Spud 4-26-51

Oil well TD 3247' 8" @ 203

Heeb 2738' Br. line 2871' KC 2895'

Cong. 3204' ReArb. 3210'

Arb. 3214-30

5" @ 3215' TD 3242' FU 240' fluid

10 hr. 500 A S/1 BOPH 1000 A

no inc. DD 3247' S/4 BOPH

Comp. 60 BOPD

COMPLETED

County Rice State KansasSec. 28 (Blk. Twp.) 19 (Sur. Rge.) 9W Map No.Operator Dozier OilWell No. 2 Farm Purcell "A"Elev. Location SW SW NE

FIRST REPORT

330 Ft. From S Line NE330 Ft. From W Line Quarter1st. Report MAY 2 1951

Completion

Remarks

Lewis Drlg. - Contr.Spudding Date 4-26-51Drlg. Data Chase Pool8" @ 203 drlg. 1925

J. E. TYRA

County Rice State Kansas

Sec. 28 (Blk. Twp.) 19 (Sur. Rge.) 9W Map No.

Operator Dozier Oil

Well No. 2 Farm Purcell "A"

Elev. 1699 Location SW SW NE

330 Ft. From S Line NE

330 Ft. From W Line Quarter

1st. Report

Completion JUN 13 1951

Remarks	Chase Pool
---------	------------

Lewis Drlg. - Contr.

Spudding Date 4-26-51

Drig. Data Oil well TD 3247

8" @ 203 Heeb. 2738 Br. lime 2871

KC 2895 Cong. 3204 ReArb. 3210

Arb. 3214-30 5" @ 3215 TD 3242

FU 240' fluid 10 hr. 500 A

S/ 1 boph 1000 A no inc.

DD 3247 S/ 4 bopm Comp. 60 bopd