

Map No. KANSAS Sec. 28 Twp. 19 R. 9W
 Well No. 3-Callie Farm _____
Gypsy Oil Company _____

NORTH

WEST

EAST

SOUTH

Location _____

Drilling Remarks _____

Rig Up _____

Drilling Remarks _____

RECORD

Cased _____ in. _____ ft.

Sand _____

Gas _____

Oil _____

Total Depth _____

PRODUCTION

1st 24 hrs. Nat. _____

1st 24 hrs. after shot _____

Gas _____ cu. ft.

Dry Hole _____

Abandoned _____

Map No. KANSAS Sec. 28 Twp. 19 R. 9W
Well No. 3- Callis Farm
Gypsy Oil Company


Ft. from N. Line

990 Ft. from S. Line

Ft. from E. Line

330 Ft. from W. Line

Elev. 1716

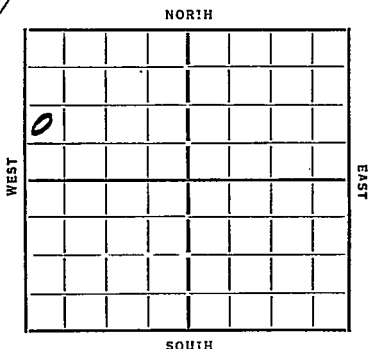

Date 1935 REPORT

8/21 Alg 163.
8/29 " 1900 12" 163
9/6 —
10/2 Sib 3246
T 7 3311
70 A.

ABANDONED

Map No. 49 Sec. 28 Twp. 19 R. 9WWell No. 3-CallisKypsy oil Company

Contractor

FIRST REPORTS

Ft. from N. Line

990 Ft. from S. Line

Ft. from E. Line

330 Ft. from W. Line

SECTION PLAT

0			

Location

Rig up

Drilling and Remarks:

163'

RECORD

Cased _____ in., _____ ft.

Sand _____

Gas _____

Oil _____

Total Depth _____

PRODUCTION

1st 24 hrs. Nat. _____

1st 24 hrs. after shot _____

Gas _____ Cu. Ft.

Dry Hole _____

Abandoned _____

Date

ORVAL MANNSCHRECK

8-21-35 192

Scout

KANSAS

Map No. 49 Sec. 28 Twp. 19 R. 9WWell No. 3-CallisKyrsgal

Company

Contractor

ABANDONED

SECTION PLAT

0			

Ft. from N. Line

990 Ft. from S. Line

Ft. from E. Line

330 Ft. from W. Line

Location

Rig up

Drilling and Remarks:

105 H

RECORD

Cased _____ in., _____ ft.

Sand 3246

Gas _____

Oil _____

Total Depth 3311

PRODUCTION

1st 24 hrs. Nat. _____

1st 24 hrs. after shot _____

Gas _____ Cu. Ft.

Dry Hole _____

Abandoned _____

Date

10-2-35 192 W. L. MANSCHRECK

Scout