


Section.....28.....Township.....19.....Range.....9-W

Well Number.....1- Campbell

Company.....Skiles et al

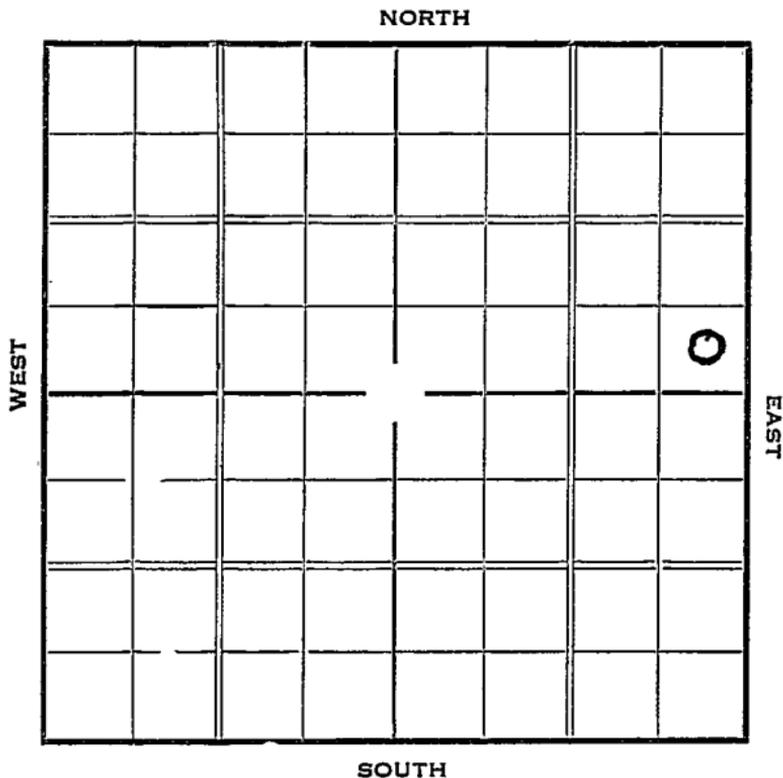

O. W. D. D

Sec. 28 Twp. 19 R. 9-W

Well No. #1 Campbell Farm

Skiles et al Company


 Ft. from N. Line

330 Ft. from S. Line

330 Ft. from E. Line

 Ft. from W. Line

Elev. 1689

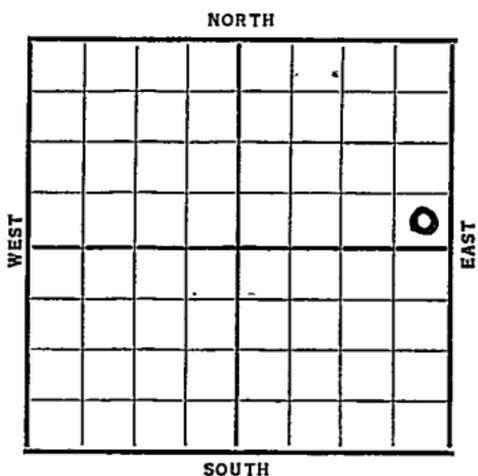

Date	REPORT O. W. D. D
1937	
5/12	Cellar & Pond
5/21	"
5/28	"
6/4	Mat.
6/11	Rig'n up.
6/19	" "
6/25	" "
7/2	" "
7/9	" "
7/16	RU & SD.
7/23	" "
7/30	R. U.
8/6	Shut down.
8/13	" "
8/20	Anhy 307'. 15" @ 307'.
	12" @ 440'. Drlg. 715'.
8/28	Drlg. 1645'.
9/3	10" @ 1615'. T.D. 1965' U.R.
9/10	8" @ 1970'. Drlg. 2175'.

OVER

1937

9/17 Topeka '2432'. T.D. 2472'.
U. R. 8".

9/21--8" 2483 Top Kansas City 2878 small show
oil 2890-2925 Pay 2950-56
T.D. 2956 Filled up 2000 feet oil in
3 hours Running 7" 2950 (Tel)

9/24 8" @ 2483'. S.G. 2305-15'.
1 B.W. 2570-90'. K.C. 2878'.
S.O. 2890-2905'. T.D. 2955'.
2000' fluid 12 hrs.

10/2 7" @ 2953'.

10/8 Swab 14 BOPH W/SW 10 hrs.
Grav. 42. Recementing 7".

10/15 Swb. 3 B.O. & 2 B.W. P.H.
T.D. 2958'.
Shot 50 shots 2953-58'.

10/22 No help. 1000 acid. No help.
Drilling deeper.

10/29 T.D. 2961'. 3000 acid.

11/5 Pumped 10 bbls. oil & 60 bbls.
water per day. Will deepen.

11/12 S. D.

11/19 "

11/26 "

12/3 "

12/10 "

12/17 "

12/24 C. O.

12/31 5" @ 3097'. Arb. 3199'.
T.D. 3202'. S.O. C.O.

OVER



1938

1/3-- Top Arbuckle 3199 T.D. 3209
1300 feet oil in hole in 14 hrs. (Tel)

1/7 Arb. 3198' (Corrected)
123' of 4" liner 3200'.
T.D. 3210'. Hole full fluid in
36 hrs. 2000 a cid.
Pumped 104 bbls. oil with
lots water in 4 hrs.

1/12--Potential 252 bbls. oil plus 85% water
U.R. 5" to shut off water (Tel)

1/20 S.D.

1/28 5" - 3198' (Cemented)
3000' oil in 18 hrs. No water.
3000 acid testing.

2/4 1750' acid.

2/9 5" @ 3198'.
Arb. 3198'.
T.D. 3210'.
Total of 8750' acid.
Potential 252 bbls.
No water.

COMPLETED

O. W. D. D

1938
9/28 Old T.D. 3210'.
Old potential 252 bbls.
Deepened to T.D. 3221' H.F.O.
Pump 181 bbls. 4 hrs. & 151 bbls.
4 hours.
Potential 905 barrels.

FIRST REPORT

and
COMPLETED

Rice **KANSAS**

Map No. 49 Sec. 28 Twp. 19 R. 9^W

Well No. 1-Campbell
Spikes et al Company

Contractor

FIRST REPORT

SECTION PLAT

			0

_____ Ft. from N. Line
330 Ft. from S. Line
330 Ft. from E. Line
 _____ Ft. from W. Line

Location _____

Rig up _____

Drilling and Remarks:

Cellar & Pond

RECORD

Cased _____ in., _____ ft.

~~Sand~~ _____

Gas _____

Oil _____

Total Depth _____

PRODUCTION

1st 24 hrs. Nat. _____

1st 24 hrs. after shot _____

Gas _____ Cu. Ft.

Dry Hole _____

Abandoned _____

Date

MAY 12 1937 19

H. D. Hatfield

Scout

724-111-507 6

1917

[Handwritten signature]

[Handwritten signature]

[Handwritten signature]

Returned	<i>[Signature]</i>
Cards	<i>[Signature]</i>
Tracing	<i>[Signature]</i>
France Map	<i>[Signature]</i>
Scarborough Map	<i>[Signature]</i>
Moody Map	<i>[Signature]</i>
Scarborough Plat Book	
Moody Plat Book	

Jew.

Returned _____

Cards _____

Tracing _____

France Map _____

Scarborough Map _____

Moody Map _____

Scarborough Plat Book _____

Moody Plat Book _____

Map No. 49 Sec. 28 Twp. 19 R. 9WWell No. 1 CampbellSkiles etal

Company

FIRST REPORT

Contractor

COMPLETED

SE NE

SECTION PLAT

			0

_____ Ft. from N. Line

330 Ft. from S. Line330 Ft. from E. Line

_____ Ft. from W. Line

Location _____

RECORD

Cased _____ in., _____ ft.

Sand _____

Gas _____

Oil _____

Total Depth _____

PRODUCTION

1st 24 hrs. Nat. _____

1st 24 hrs. after shot _____

Gas _____ Cu. Ft.

Dry Hole _____

Abandoned _____

Drilling and Remarks:

OWDD-OTD 3210

Old. Poten. 252

Dpnd. to TD 3221

Pump 181/4^{hrs} HFO.

151/4

Poten. 905

Date

SEP 28 1938

19

H. D. Hatfield Scout

RAY

Returned
Cards Paul
Tracing Jim
France Map
Scarborough Map
Moody Map
Scarborough Flat Book
Moody Plat Book