

O.W.P.B.


Rice

KANSAS

Section 28 Township 19 Range 9-W

Well No. 1 Purcell


Company Cities Service Oil

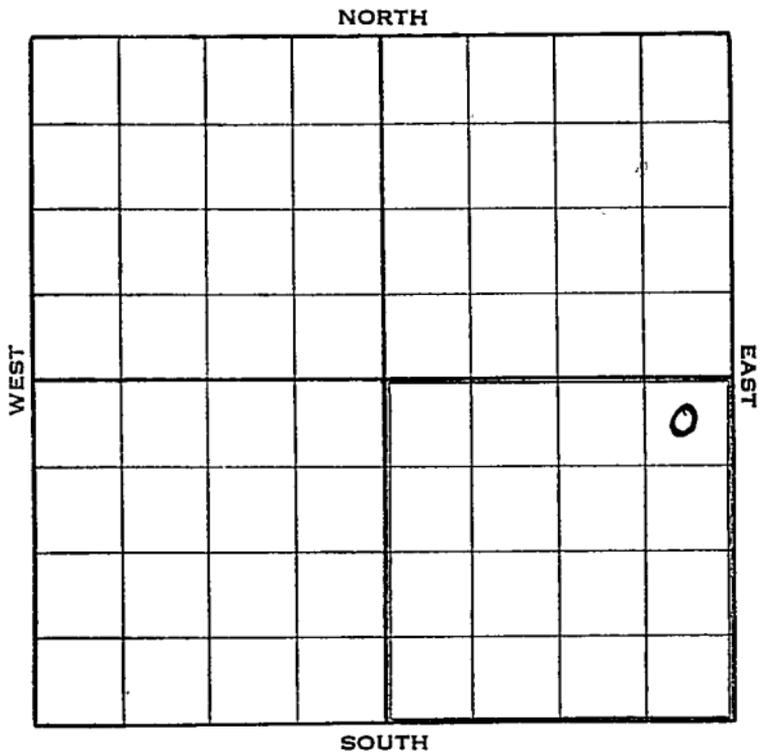

Sec. 28 Twp. 19 R. 9-W

Well No. #1 Purcell Farm
Cities Service Oil Company

330 Ft. from N. Line
_____ Ft. from S. Line
330 Ft. from E. Line
_____ Ft. from W. Line
Elev. 1683

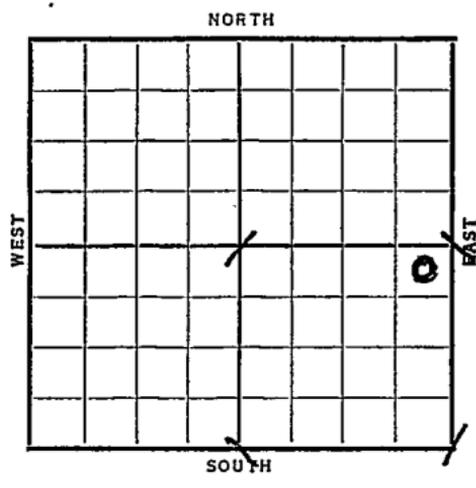

Date	REPORT
1938	
3/2	Location
3/11	R U R
3/18	10" @ 189'. - Drl g. 2330'.
3/25	K.C. 2870'. Arb. 3187'.
	T.D. 3191'. 7" @ 3188'.
	S.O. RUST.
4/1	Arb. 3184' (Corrected)
	7" @ 3185'. T.D. 3204'.
	Pump 120 oil in 3 hrs.
	3000 acid.
4/8	At T.D. 3204' pumped 386 oil
	in 24 hrs. Deepened to
	3212' T.D. 1250' oil 14 hrs.
	3000 acid.
	OVER

1938

4/13

7" @ 3185'.

Arb. 3184'.

T.D. 3204'.

3000 acid.

Potential 724 bbls. Nat'l.

COMPLETED

1952

10/15

D&A TD 3223'

Lans. 2870' Arb. 3184

7" @ 3185 OTD 3223' PB 3169

55/ 2921-42 1000 A

P/ 9 bw 16 hr. D&A

O. W. P. B.

FIRST REPORT

+

ABANDONED

Rice KANSAS

Map No. 49 Sec. 28 Twp. 19 R. 9W,Well No. 1 PurcellCities Service Oil Company

Contractor

FIRST REPORT


SECTION PLAT

330 NE SE
Ft. from N. Line

Ft. from S. Line

330 Ft. from E. Line

Ft. from W. Line

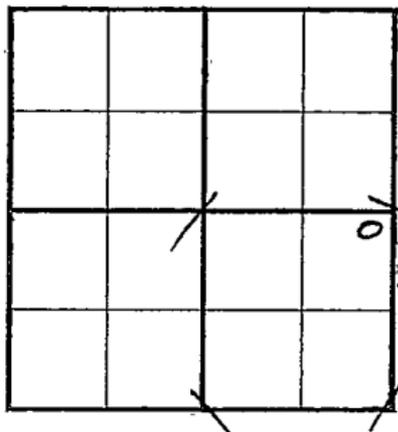Location X

Rig up _____

Drilling and Remarks:

RECORD

Cased _____ in., _____ ft.

Sand _____

Gas _____

Oil _____

Total Depth _____

PRODUCTION

1st 24 hrs. Nat. _____

1st 24 hrs. after shot _____

Gas _____ Cu. Ft.

Dry Hole _____

Abandoned _____

Date

MAR 2 - 1938H. D. Hatfield Scout

Handwritten scribbles and lines, possibly representing a map or diagram.

Handwritten signature or initials.

Returned	_____
Cards	<i>Paul</i>
Tracing	<i>Joe</i>
France Map	<i>Paul</i>
Scarborough Map	<i>Paul</i>
Moody Map	_____
Scarborough Plat Book	_____
Moody Plat Book	_____

Map No. 49 Sec. 28 Twp. 19 R. 9WWell No. 1 PurcellCities Service Oil Company

Contractor

COMPLETED

NE SE

330 Ft. from N. Line

_____ Ft. from S. Line

330 Ft. from E. Line

_____ Ft. from W. Line

SECTION PLAT

			0

Location _____

Rig up _____

Drilling and Remarks:

*3000 acid**POT 724***RECORD**Cased 7 in., 3185 ft.Sand Arb 3184

Gas _____

Oil _____

Total Depth 3204**PRODUCTION**

1st 24 hrs. Nat. _____

1st 24 hrs. after shot _____


Gas _____ Cu. Ft.

Dry Hole _____

Abandoned _____

Date

APR 13 1938 19H. D. Hatfield Scout

 

Returned	
Cards	<i>Paul</i>
Tracing	<i>Joe</i>
France Map	
Scarborough Map	<i>RCH</i>
Moody Map	
Scarborough Plat Book	
Moody Plat Book	

O. W. P. B.


County Rice State Kansas

Sec. 28 (Blk. Twp.) 19 (Sur. Rge.) 9W Map No.

Operator Cities Service Oil

Well No. 1 Farm Purcell

Elev. 1683 Location NE NE SE

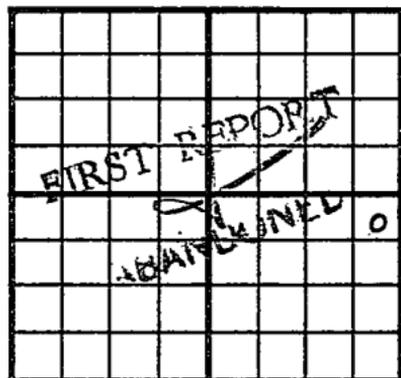

330 Ft. From N Line SE

330 Ft. From E Line Quarter

OCT 15 1957

Ist. Report

Completion OCT 15 1957

Remarks OWPB

O. W. P. B.

Spudding Date

Drilg. Data D & A TD 3223

Lans. 2870 Arb. 3184 7" @ 3185 OTD3223

PB 3169 55/ 2921-42 1000 A

P/ 9 bw 16 hr.

D & A

Scout Cards	20
Land Small Map	
Land Wall Map	3
Tracings	
France Map	
Pierce Map	
Misc	

OCT 20 1952

Orig. Date