

Rice

KANSAS


Form 51—5M—11-38—Palace

Section 28 Township 19 Range 9-W

Well No. #1 Charles (Callis)

Company Gulf

NORTH Campbell Pool

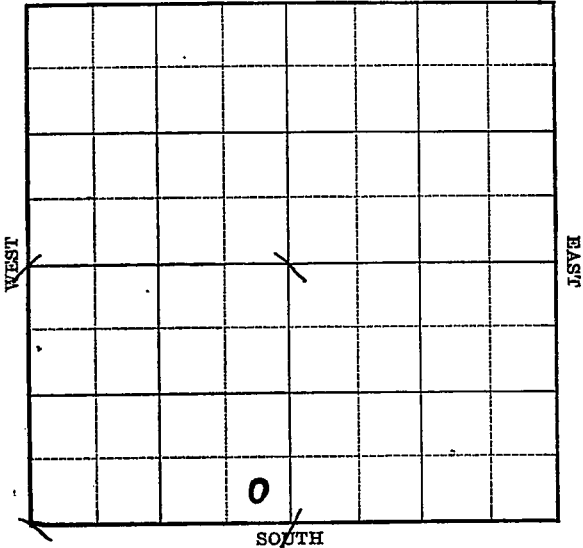

KANSAS

Rice

Sec. 28 Twp. 19 R. 9-W

Well No. #1 Charles (Callis) Farm

Gulf _____ Company
(Campbell)


_____ Ft. from N. Line

330 Ft. from S. Line

330 Ft. from E. Line

Ft. from W. Line

Ele v. 1697'

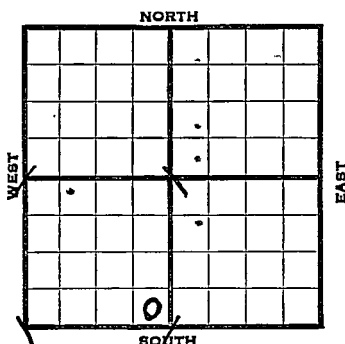

1939	REPORT
4/12	9" - 213' WOC.
4/21	Drlg. 2285'
4/28	Lans. 2878' SSO & G 2907-10' SSO 2964' Coring 3202'
5/5	Cong. 3198' Arb. 3207' 7" - 3208' T.D. 3208' show oil
5/12	T.D. 3228' 1000 acid. Pump 54½ oil 6½ hrs. Pumped down hole filled up 250' oil and 450' water 6 hours.
5/19	T.D. 3258' Swab 2 bbls. fluid 1 hour. P. B. 3253' Swab 1/4 barrel oil per hour. Trace water.
5/26	Shot 90 qts. 3278-53' C. O.
6/1	" " " " "
	OVER

1939

6/7--Arb. 3207

7" 3208

T.D. 3258

P.B. 3253

Shot 90 qts. 3218-53

Pot. 175 oil 145 water pump

COMPLETED

Rice

KANSAS

Map No. 49 Sec. 28 Twp. 19 R. 9WWell No. 1 Charles (Callis)

Gulf


Company

Contractor

FIRST REPORT

SE SW

SECTION PLAT

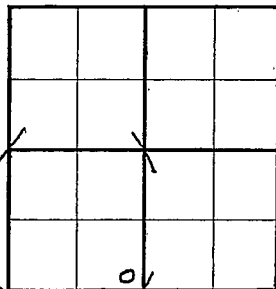

Ft. from N. Line

330 Ft. from S. Line330 Ft. from E. Line

Ft. from W. Line

CAMPBELL POOL

Location _____

Rig up _____

Drilling and Remarks:

9" - 213

WOC

RECORD

Cased _____ in., _____ ft.

Sand _____

Gas _____

Oil _____

Total Depth _____

PRODUCTION

1st 24 hrs. Nat. _____

1st 24 hrs. after shot _____

Gas _____ Cu. Ft.

Dry Hole _____


Abandoned _____

Date

APR 12 1939

19

H. D. Hatfield, Scout

 

10. 12 800

20 2 100

11 7 10 100

11 10

CASE

100

100

Misc. Small Maps	Ray
Cards	Ray
Tracing	Ray
France Map	Ray
Scarborough Map	Ray
Moody Map	
Geological Dept.	✓
Moody Flat Book	

100

Map No. _____ Sec. 28 Twp. 19 R. 9WWell No. 1 Charles (Callis)

Gulf


Company

Contractor

COMPLETED

SE SW

SECTION PLAT

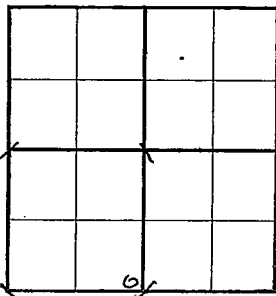

_____ Ft. from N. Line

330 Ft. from S. Line330 Ft. from E. Line

_____ Ft. from W. Line

CAMPBELL POOL

Location _____

Rig up _____

Drilling and Remarks:

*Cu & 3207**7" @ 3208**P.B 3253**Bl. & 909 to 3218-53**Po & 175 oil 145**water pump*

RECORD

Cased _____ in., _____ ft.

Sand _____

Gas _____

Oil _____

Total Depth 3258

PRODUCTION

1st 24 hrs. Nat. _____

1st 24 hrs. after shot _____

Gas _____ Cu. Ft.

Dry Hole _____

Abandoned _____

Date

JUN 7 1939

19

S. J. LEWIS

Scout

Misc Small Maps	Ray
Cards	Ray
Tracing	Jr
France Map	Ray
Searborough Map	Ray
Moody Map	Ray
Geological Dept	
Moody Plat Book	