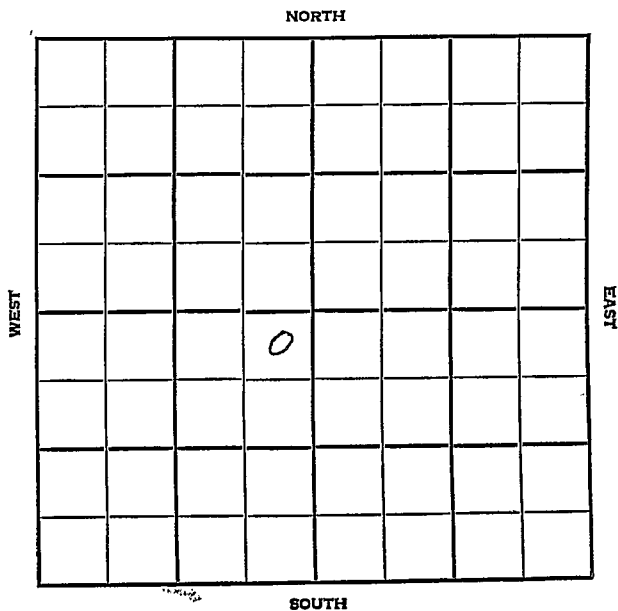


Section 28 Township 19 Range 2 WWell No. #1 GoeringCompany Artnell

McPherson

KANSAS

SEC. 28	TWP. 19	R. 2W
------------	------------	----------

WELL NO.

#1 Goering

FARM

COMPANY

Artnell

CONTRACTOR

Leben Drlg.

Ritz-Canton


Ft. from N. Line

Ft. from S. Line

Ft. from E. Line

Ft. from W. Line

NE NE SW

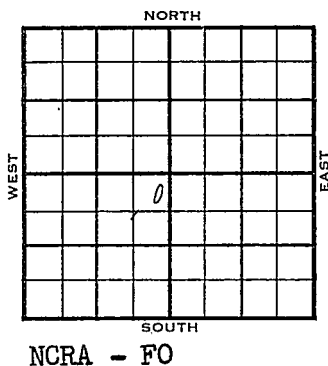

1956

ELEVATION

REPORT

#1

2-8

Comm. 2-2-56

8" @ 170/125

Drlg. 2500

County McPherson Elev. 1538
 Sec. 28 Twp. 19 Rge. 2W
 Company Artroll
 Farm Name Goering No. 1

TOPS	DEPTH	LOG	DATUM
Anh.			
Tp.			
H.			
Tr.			
Dg.			
Bl.			
L.			
K.C.			
B.K.C.			
Ce.			
C.			
M.			
M.			
K.			
Mz.			
Mo.			
V.			
S.			
S.			
A.			
R.			
Pe.			
G.			
T.D.			

Loc. in Sec.

NE NE SW

Geol.

Contr.

Leben Drlg.

Pool

Ritz-Canton

FIRST REPORT

FEB 8 '56

Date Comm. 2-2-56

NCRA - FO

8" @ 170/125 drlg. 2500

County McPherson Elev. 1538
 Sec. 28 Twp. 19 Rgs. 2W
 Company Artnell
 Farm Name Goering No. 1

TOPS	DEPTH	LOG	DATUM	Loc. in Sec.
Anh.				NE NE SW
Ip.				
H.				
Tr.				
Dg.				
BL.				
L.				Geol.
K.C.				Contr.
R.K.C.				Leben Drlg.
Ce.				Pool
C.	2963		1425	Ritz-Canton
M.	2972		1440	
M.				
K.				
Mz.				
Me.				
V.				
S.				
S.				
A.				
R.				
PE.				
G.				
TD	2990			

ABANDONED
 FEB 15 1956

Date Comm. 2-2-56 NCRA - FO

8" @ 170/125 drlg. 2500 FEB 15 '56

U.S.A.

U.S.A.