

DX 78-1

McPherson KANSAS

Section 28 Township 19 Range 2W

Well No. 3 J. J. Koehn

Company National Assoc. Pet

NORTH

WEST									EAST
SOUTH									

SOUTH

McPherson KANSAS

SEC.	28	TWP.	19	R.	2W
------	----	------	----	----	----

WELL NO. 3 J. J. Koehn FARM

COMPANY National Assoc Pet

CONTRACTOR Lincoln-Contr.
Lively Pool

990

Ft. from N. Line


Ft. from S. Line

330

Ft. from E. Line

Ft. from W. Line

SE NE SE

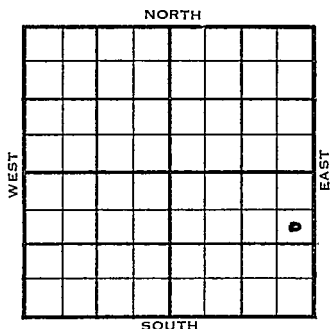

1954

ELEVATION

1551'

REPORT

6/15

M I R

6/23

8" @ 160'

Lans 2332', Miss 2967'

RTD 2974'

5" @ 2967'

6/30

CO 2974 S/26 BO + 1½ BW 20 hrs.

7/21

NR

8/4

Spud 6-14-54 Oil well TD 2974

8" @ 160 Lans. 2332 Miss 2967

TD 2974 5" @ 2967 CO to 2974

S/26 BO 1½-BW 20 hr.

Comp. 27 BOPD 33% wtr.

COMPLETED

J. G. McGEHEE

J. G. McGEHEE