

DX 78-1


McPherson

KANSAS

Section 27 28 Township 19- Range 2W

Well No. #4 Lively

Company National Assoc. Pet.

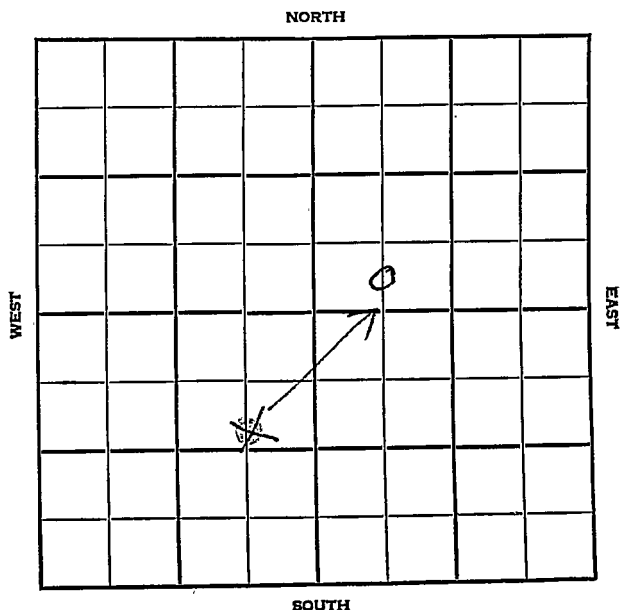

McPherson

KANSAS

SEC.	TWP.	R.
27-28	19	2W

WELL NO.

4 Lively

FARM

COMPANY

National Assoc. Pet.

CONTRACTOR

Lincoln

Ritz-Canton


Ft. from N. Line

330 Ft. from S. Line

Ft. from E. Line

660 Ft. from W. Line

SW NE
C S $\frac{1}{2}$ NE SW

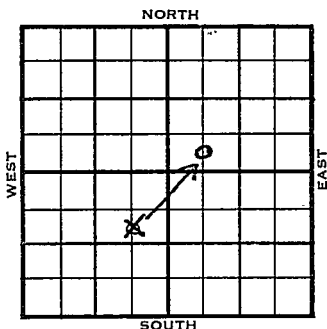

1955	ELEVATION	REPORT
------	-----------	--------

5/26

M I R

6/15

Comm. 5-17-55

8 5/8", $\frac{1}{4}$ 162 5 1/2" @ 2958/75 DD 2969,

FU 200' oil 400' wtr. 6 hr. frac

S/6 bo 12 bwph 6 hr. Comp 15 bopd

50 bw.

Tps.

Depth

Datum

L.

2337

793

M.

2958

1414

TD.

2963

COMPLETED

Co. 1 Feet 10

FIRST REPORT

Farm Name Lively No. 4

TOPS	DEPTH	LOG	DATUM	Loc. in Sec.
Anh.				C S $\frac{1}{2}$ NE SW
TP.				
H.				
Tr.				
Dg.				
BL.				
L.				Geol.
K.C.				Contr.
B.K.C.				Lincoln
Ce.				
C.				Pool
M.				Ritz-Canton
M.				
K.				
Mz.				
Me.				
V.				
S.				
S.				
A.				
R.				
P.C.				
G.				
TP.				

Date Comm. _____

RE I R

SCOUT TICKET

DX-201

Kansas

SEC.

TWP.

R.

28

19

2W

WELL NO.

4 Lively

FARM

COMPANY

National Assoc. Pet.

CONTRACTOR

CORRECTION

C S $\frac{1}{2}$ SW NE

____ FT. FROM N. LINE

330


____ FT. FROM S. LINE

____ FT. FORM E. LINE

660

____ FT. FROM W. LINE

NORTH

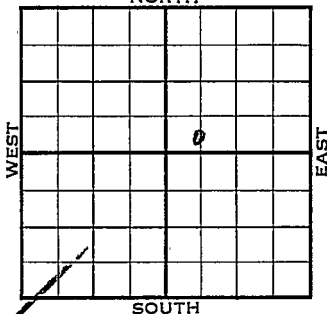

McPherson County

☐

LOCATION

☐

RIG UP

DRILLING AND REMARKS:

Reported

C S $\frac{1}{2}$ NE SW

27-19-2W

RECORD

CASED

IN.,

FT.

SAND

GAS

OIL

TOTAL DEPTH

1ST 24 HRS. NAT.

1ST 24 HRS. AFTER SHOT

GAS

CU. FT.

DRY HOLE

ABANDONED

PRODUCTION

DATE

JUN 1 5 1955

SCOUT

L. J. Harris

County McPherson Elev. 1544
 Sec. 28 Twp. 19 Rge. 2W
 Company National Assoc. Pet.
 Farm Name Lively No. 4

TOPS	DEPTH	LOG	DATUM	Loc. in Sec.
Anh.				C S $\frac{1}{2}$ SWNE
Tr.				
Dg.				
Bl.				
L.	2337		793	
K.C.				Geol.
B.K.C.				Contr.
C.				Lincoln
M.	2958		1414	Pool
M.				Ritz-Canton
K.				o
Mz.				
Mq.				
V.				
S.				
S.				
A.				
R.				
PE.				COMPLETE
G.				
T.D.	29103			

Date Comm. 5-17-55 JUN 15 1955

8 5/8" @ 162 5 $\frac{1}{2}$ " @ 2958/75

DD 2969 FU 200' oil 400' wtr. 6 hr.

frac S/ 6 bo 12 bwph 6 hr.

Comp. 15 bopd 50 bw