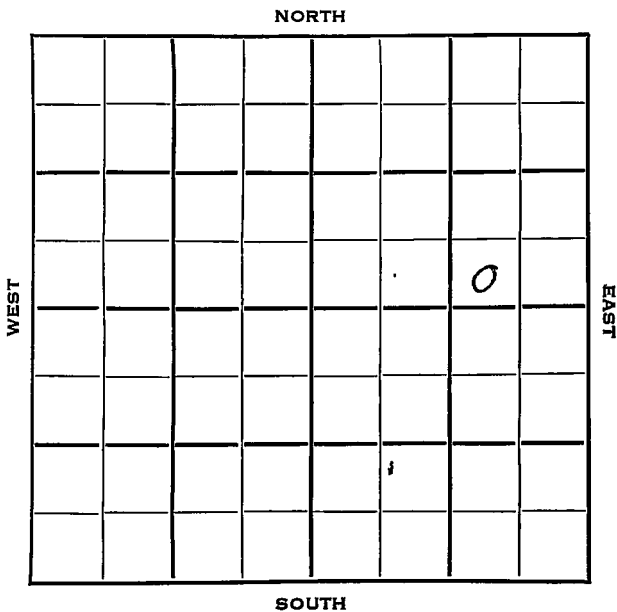


Section 28 Township 19 Range 2WWell No. #2 LivelyCompany National Assoc. Pet.

McPherson

KANSAS
2W

Sec. 28 Twp. 19 R. 2W

Well No. #2 Lively Farm

National Assoc. Pet. Company

Exploration Drlg. Contractor

Lively Pool


 Ft. from N. Line

330 Ft. from S. Line

990 Ft. from E. Line

 Ft. from W. Line

SW SE NE

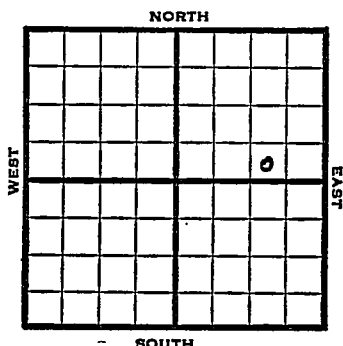

1953 Elev. 1518' REPORT

4/29 5/7	Drlg 450' 8" @ 162' Lans 2332' Drlg 2945'
5/21	Miss 2958 RTD 2964 5" @ 2959 CO 2964' S/3 GW plus 12 GOPH 8 hrs. 500 A
5/28	5 go / 1 bw DD 2979 500 A S/ 7 bo / 33 bw 4 hrs.
6/21	P/21 BO / 27 BWPD
7/1	N.R.
7/8	Spud 4-25-53 OilWell TD 2979 8" @ 162 Lans 2332, Miss 2958, TD 2964 5" @ 2959, CO to 2964, S/3 gw 12 goph, 500A 5 go 1 bw DD 2979, 500A S/7 bo 33 bw 4 hrs. P/31 bo 65 bwpd P/21 bo 27 bwpd Comp. 25 bopd 60% wtr.

COMPLETED

County McPherson State Kansas
 Sec. 28 (Blk. 19) (Sur. 2W) (Twp. 19) Map No.
 Operator National Assoc. Pet.
 Well No. 2 Farm Lively
 Elev. 1548 Location SW SE NE

330 Ft. From S Line NE
990 Ft. From E Line Quarter

Ist. Report

Completion JUL 8 1953

Remarks Lively Pool

Exploration Drlg. - Contr

Spudding Date 4-25-53

Drlg. Data Oil well TD 2979

8" @ 162 Lans. 2332 Miss. 2958

TD 2964 5" @ 2959 CO to 2964

S/ 3 gw 12 goph 500 A 5 go 1 bw

DD 2979 500 A S/ 7 bo 33 bw 4 hr.

P/ 31 bo 65 bwpd P/ 21 bo 27 bwpd

Comp. 25 bopd 60% wtr.

J. G. McGEHEE