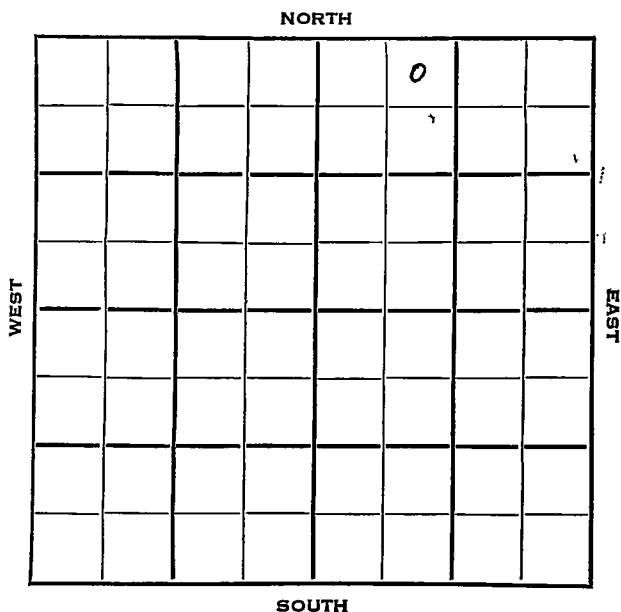


Section 28 Township 19 Range 2 WWell No. # 2 UnruhCompany Nat'l Assoc. Pet.

McPherson

KANSAS

SEC.	TWP.	R.
28	19	2 W ✓

WELL NO.

2 Unruh

FARM

COMPANY

Nat'l Assoc. Pet.

CONTRACTOR

Lincoln

Lively Pool


330 Ft. from N. Line

Ft. from S. Line

Ft. from E. Line

990 Ft. from W. Line

NE NW NE

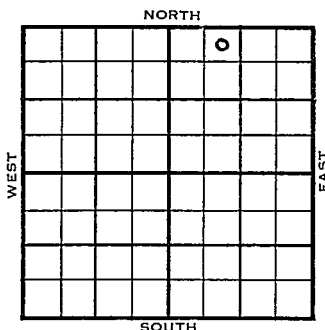

	ELEVATION	REPORT
1954	1538'	

5/12 Spud 5-7-54

8" @ 160

Drlg. 1800'

5/19 KC 2330 Miss 2950'

RTD 2958 5" @ 2953

5/26 DD 2964'

6/2 TD 2968 S/1 BO + 2 BWPH 6 hrs. POP

6/9 NR

7/7 Spud 5-7-54 Oil well TD 2968

8" @ 160 KC 2330 Miss 2950

TD 2958 5" @ 2953 DD 2964

DD 2968 S/1 BO 2 BWPH 6 hr.

Comp. 27 BOPD 70% wtr.

COMPLETED

County McPherson State Kansas
 Sec. 28 (Blk. Twp.) 19 (Sur. Rge.) 2W Map No.
 Operator Nat'l Assoc. Pet.
 Well No. 2 Farm Unruh
 Elev. _____ Location NE NW NE

330 Ft. From N Line NE990 Ft. From W Line Quarter1st. Report MAY 1 2. 1954

Completion _____

Remarks _____

Lincoln - Contr.Spudding Date 5-7-54Drlg. Data Lively Pool8" @ 160 drlg. 1800

County McPherson State Kansas
 Sec. 28 (Blk. 19) (Sur. 2W) Map No.
 Operator National Assoc. P_et.
 Well No. 2 Farm Unruh
 Elev. 1538 Location NE NW NE

330 Ft. From N Line NE
 990 Ft. From W Line Quarter

1st. Report

Completion JUL 7 1954

Remarks Lively Pool

Lincoln - Contr.

Spudding Date 5-7-54

Drlg. Data Oil well TD 2968
8" @ 160 KC 2330 Miss. 2950
TD 2958 5" @ 2953 DD 2964 DD 2968
S/ 1 bo 2 bwph 6 hr.
Comp. 27 bopd 70% wtr.

J. G. McGEHEE