


Section 28 Township 19 Range 11 WWell No. # 3 HallCompany Honaker Drlg.

NORTH

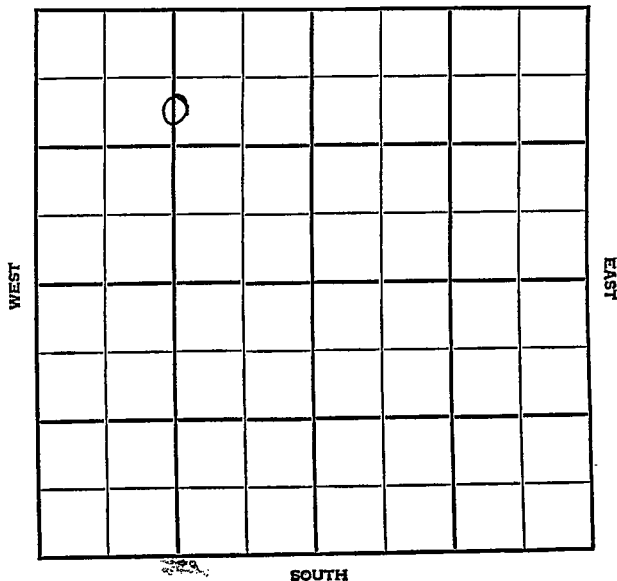

Barton KANSAS

SEC.	TWP.	R.
28	19	11W

WELL NO.

3 Hall

FARM

COMPANY

Honaker Drlg.

CONTRACTOR

Co. Tools

SW Heizer Pool


990 Ft. from N. Line

Ft. from S. Line

Ft. from E. Line

1320 Ft. from W. Line

C S/2 N/2 NW

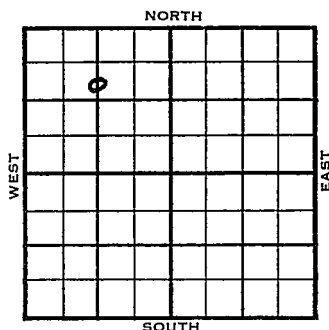

1954

ELEVATION

1893'

REPORT

12/1

Spud 11-27-54

8" @ 817'

Drlg. 1550'

12/8

Spud 11-27-54

D & A

TD 3327'

8" @ 817'

Heeb 3121', Br. Lime 3215' Lans 3228'

DST 3230'-38' opn $\frac{1}{2}$ hr, rec 8' Mud 0#

TD 3327'

D & A

ABANDONED

County **Barton** State **Kansas**Sec. **28** (Blk.) **19** (Sur.) **14W** Map No.Operator **Honaker Drlg.**Well No. **3** Farm **Hall**Elev. Location **C S $\frac{1}{2}$ N $\frac{1}{2}$ NW**

990 Ft. From **N** Line **NW**1320 Ft. From **W** Line **Quarter**1st. Report **DEC 1 1954**


Completion

Remarks

Co. toolsSpudding Date **11-27-54**Drlg. Data **SW Heizer Pool****8" @ 817 drlg. 1550**

FABEN GILSTRAP

County Barton State Kansas
 Sec. 28 (Blk. 19) (Sur. 14W) Map No.
 Operator Honaker Drlg.
 Well No. 3 Farm Hall
 Elev. 1893 Location C S $\frac{1}{2}$ N $\frac{1}{2}$ NW

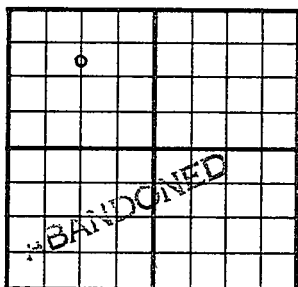

990 Ft. From N Line NW
1320 Ft. From W Line Quarter
 Ist. Report
 Completion DEC 8 1954
 Remarks SW Heizer Pool
Co. tools
 Spudding Date 11-27-54

Drlg. Data D & A TD 3327
8" @ 817 Heeb. 3121 Br. lime 3215
Lans. 3228 DST 3230-38 open $\frac{1}{2}$ hr.
Rec. 8' mud 0# TD 3327

D & A

FABEN GILSTRAP