

Barton

DX 78-1


KANSAS

Section 28 Township 19 Range 14W

Well No. #2 Hall

Company Honaker Drlg. Co.

NORTH

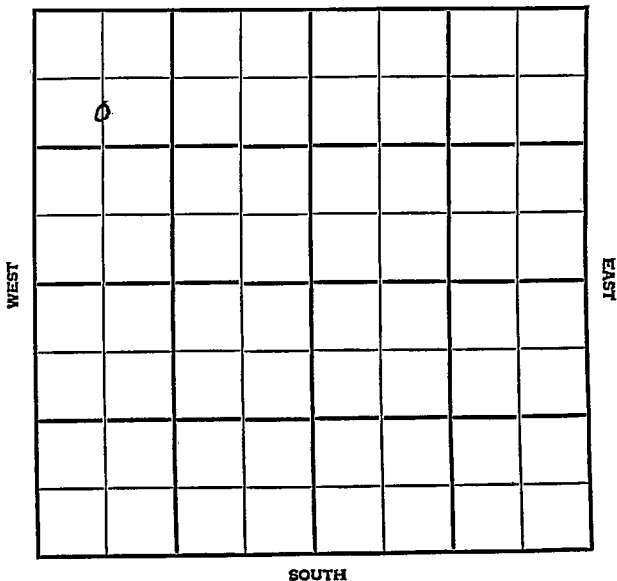

Barton

KANSAS

SEC.	TWP.	R.
28	19	11 W

WELL NO.

# 2 Hall

FARM

COMPANY

Honaker Drlg. Co.

CONTRACTOR

Co. tools


SW Heizer Pool

990 Ft. from N. Line

Ft. from S. Line

Ft. from E. Line

660 Ft. from W. Line

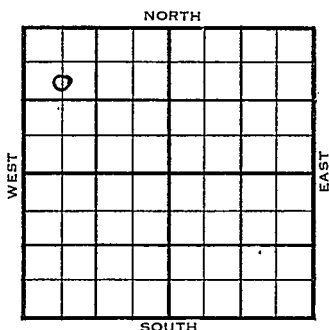C S $\frac{1}{2}$  NW NW

	ELEVATION	REPORT
1954	1895'	

9/15 Spud 9-11-54  
8" @ 819 WOC

10/27 Spud 9-11-54  
Oil Well  
TD 3492'  
8" @ 819'  
Heeb 3101', Br. Lime 3187', Lans  
3200'  
DST 3204'-12' opn 20 min, gas in 2 min  
2,100,000 cfg. 30' gcm 1120#  
DST 3221'-66' opn  $\frac{1}{2}$  hr, gas in 6 min  
1000' oil, 1200#  
DST 3324'-72' opn 1 hr, gas in 7 min  
rec 2400' oil, 1250# Cong 3442' Qtz.  
3490'  
TD 3492'  
5" @ 3491'  
CO 28/ 3359-69 500 A  
S/ 40 $\frac{1}{2}$  bo 1 hr. S/ 16 $\frac{1}{2}$  boph 4 hr.  
P/ 16 boph  
Comp 315 bopd.

COMPLETED



County Barton State Kansas

Sec. 28 (Blk.) 19 (Sur.) 14W Map No.

Operator Honaker Drlg.

Well No. 2 Farm Hall

Elev. 1895 Location C S  $\frac{1}{2}$  NW NW


990Ft. From N Line NW c

660Ft. From W Line Quarter

Ist. Report

Completion OCT 27 1954

Remarks SW Heizer Pool

Co. tools

Spudding Date 9-11-54

Drlg. Data Oil well TD 3492

8" @ 819 Heeb. 3101 Br. lime 3187

Lans. 3200 DST 3204-12 open 20 min.

gas in 2 min. 2,100,000 cfg 30' gcm

1120# DST 3221-66 open  $\frac{1}{2}$  hr. gas in

6 min. 1000' oil 1200# DST 3324-72

open 1 hr. gas in 7 min. rec. 2400' oil

1250# Cong. 3442 Qtz. 3490 TD 3492

5" @ 3491 CO 28/ 3359-69 500 A

S/ 40  $\frac{1}{2}$  bo 1 hr. S/ 16  $\frac{1}{2}$  boph 4 hr.

P/ 16 boph Comp. 315 bopd