

KANSAS

FORM 515M 10-41 PETROL

Rush

Section 28 Township 19 Range 17-W

Well No. #1 Bannon

Company Helmerich & Payne

Wildcat

NORTH

WEST

EAST

04 P							

SOUTH

Sec. 28 Twp. 19 R. 17W

Well No. 1-Bannon Farm

Helmerich & Payne Company

(Wildcat)

330

~~660~~

Ft. from N. Line

Ft. from S. Line


Ft. from E. Line

330

~~660~~

Ft. from W. Line

Elev. 2130

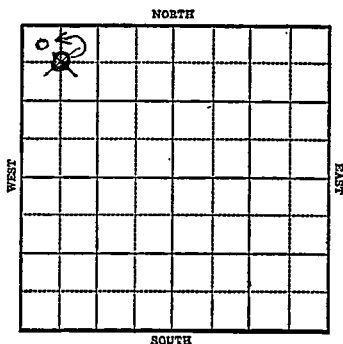

1942

R E P O R T

9/30

Dlg. 100

10/7

8" - 1221

Anhy 1215

Drlg. 2350

10/14

Lans. 3535

Drlg. 3608'

10/21

Arb. 3892

No shows.

T.D. 3960

ABANDONED

Handwritten calculations:

$$\begin{array}{r} 3892 \\ 2130 \\ \hline 1762 \end{array}$$

$$\begin{array}{r} 3535 \\ 2130 \\ \hline 1405 \end{array}$$

KANSAS


Rush

Map No. 8/ Sec. 28 Twp. 19 R. 17WWell No. 1 BannonHelmerich & Payne Company

Contractor

C NW NW

SECTION PLAT

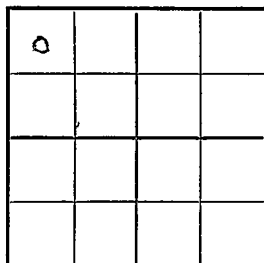660 Ft. from N. Line Ft. from S. Line Ft. from E. Line660 Ft. from W. Line

WILDCAT

Location Rig up

Drilling and Remarks:

Drlg. 100'

RECORD

Cased in., ft.Sand Gas Oil Total Depth

PRODUCTION

1st 24 hrs. Nat. 1st 24 hrs. after shot Gas Cu. Ft.Dry Hole Abandoned

Date FIRST REPORTS

S. J. LEWIS

SEP 30 1942

19

Scout

Rush

Map No. 81 Sec. 28 Twp. 19 R. 17WWell No. 1 BrannonHelmerich & Payne CompanyCORRECTION Contractor

NW/C

SECTION PLAT

0			

330 Ft. from N. Line Ft. from S. Line Ft. from E. Line330 Ft. from W. Line

WILDCAT

Location Rig up

Drilling and Remarks:

Reported

C NW NW

RECORD

Cased in., ft.Sand Gas Oil Total Depth

PRODUCTION.

1st 24 hrs. Nat. 1st 24 hrs. after shot Gas Cu. Ft.Dry Hole Abandoned

Date

OCT 1 4 1942 19S. J. LEWIS Scout

Map No. 81 Sec. 28 Twp. 19 R. 17WWell No. 1 BrannonHelmerich & Payne

Company

ABANDONED

Contractor

NW/C

SECTION PLAT

330

Ft. from N. Line

Ft. from S. Line

Ft. from E. Line

330

Ft. from W. Line

0			

WILDCA T

Location

Rig up

Drilling and Remarks:

Ac 83892No shows

RECORD

Cased _____ in., _____ ft.

Sand _____

Gas _____

Oil _____

Total Depth 3960

PRODUCTION

1st 24 hrs. Nat. _____

1st 24 hrs. after shot _____

Gas _____ Cu. Ft.

Dry Hole _____

Abandoned _____

Date

OCT 21 1942

19

S. J. LEWIS Scout