

Rush


Section 28 Township 19 Range 19W

Well No. #1 Seltman

Company M. B. Armer

16

NORTH

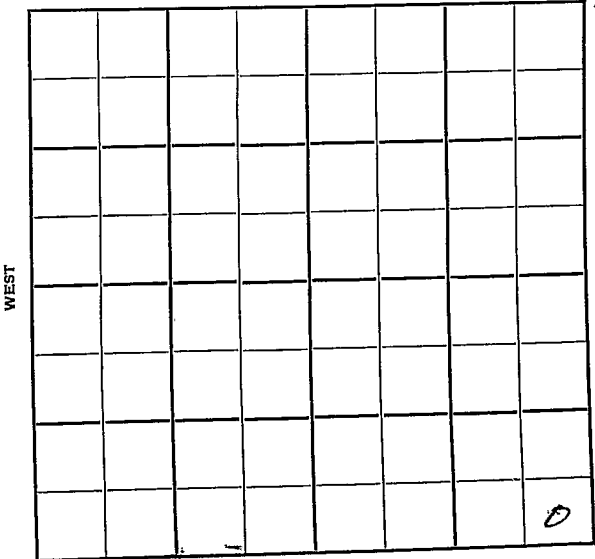

WEST

EAST

SOUTH

Rush **KANSAS** ✓
19 R. 19W

Sec. 28 Twp. _____

Well No. #1Seltman Farm _____

M. B. Armer Company _____


Wildcat Contractor _____

_____ Ft. from N. Line

330 Ft. from S. Line

330 Ft. from E. Line

_____ Ft. from W. Line

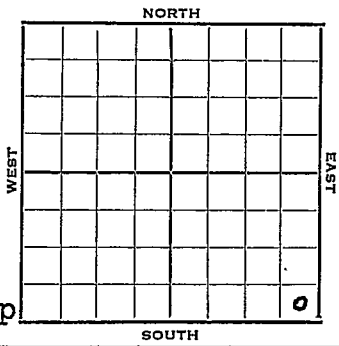

SE SE SE
Magnolia & CSO -Sup

1953 Elev. 2271' REPORT

3/18 Location
 3/26 " "
 4/2 " "
 4/9 " "
 4/16 8" @ 238'
 Anhy
 Drlg 1660'
 4/23 Drlg. 3647'
 4/29 Spud 4-11-53
 D & A
 TD 4284'
 8" @ 238'
 Heeb 3677, Lans 3728, B KC 4041, Marm
 4063,
 DST 4150-76 opn 1/2 hr. rec 2725' sw
 1240# Arb 4204, Cong 4152,
 TD 4284
 D & A

ABANDONED

