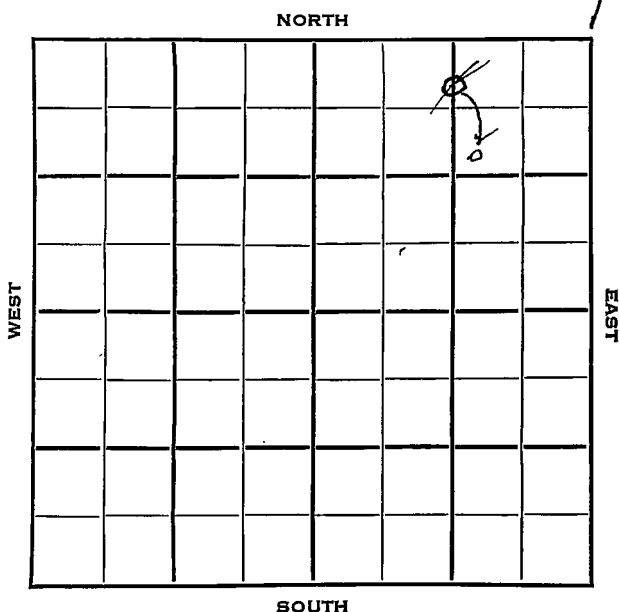


Section 28 Township 19 Range 13WWell No. 1 HonakerCompany Joe J. Honaker

Barton KANSAS

SEC.	TWP.	R.
28	19	13W ✓

WELL NO.

1 Honaker

FARM

COMPANY

Joe J. Honaker

CONTRACTOR

Honaker

St. Bend Townsite Pool


NORTH

~~330~~ 900 Ft. from N. Line

Ft. from S. Line

~~1320~~ Ft. from E. Line

1480 Ft. from W. Line

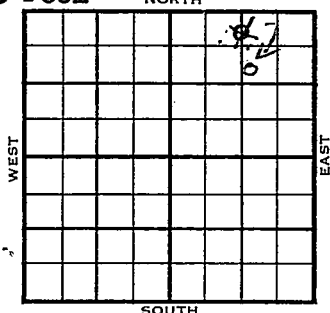SW NENE
G-N-L-NE

1953

ELEVATION

1845'

REPORT

12/9

Spud 12-4-53

Anhy 730'

8" @ 740'

Drlg. 1523'

12/16

Spud 12-4-53

D&A

TD 3453'

Anhy 730'

8" @ 740'

Heeb 3058', Br lime 3157', Lans 3170'

DST 3173-85', opn 30 mins., rec.

10' mud, off

DST 3191-3250', opn 20 mins., rec.

30' vsocm,

Cong 3414'

TD 3453'

D&A

ABANDONED

J. G. McGEHEE

Map No. _____ Sec. 28 Twp. 19 R. 13WWell No. 1 HonakerJoe J. Honaker Company _____CORRECTION Contractor _____

SW NE NE

SECTION PLAT

			o

900 Ft. from N. Line

_____ Ft. from S. Line

_____ Ft. from E. Line

1480 Ft. from W. Line

Barton County

Location _____

Rig up _____

Drilling and Remarks:

Reported
C N L NE

RECORD

Cased _____ in., _____ ft.

Sand _____

Gas _____

Oil _____

Total Depth _____

PRODUCTION

1st 24 hrs. Nat. _____

1st 24 hrs. after shot _____

Gas _____ Cu. Ft.

Dry Hole _____

Abandoned _____

Date


DEC 9 1953

19

J. G. McGEHEE

Scout

County Barton State Kansas
 Sec. 28 (Blk. 19 (Sur. 13W Map No.
 (Twp.) (Rge.)
 Operator Joe W. Honaker
 Well No. 1 Farm Honaker
 Elev. 1845 Location SW NE NE

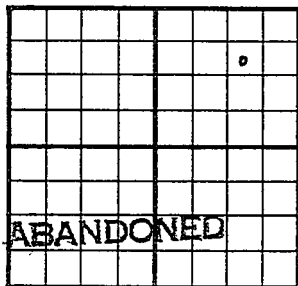

990 Ft. From N Line NE
1480 Ft. From W Line Quarter
 Ist. Report
 Completion DEC 16 1953
 Remarks Gt. Bend Townsite
Honaker - Contr.
 Spudding Date 12-4-53

Drlg. Data D & A TD 3453
Anhy 730 8" @ 740 Heeb. 3058
Br. lime 3157 Lans. 3170 DST 3173-85
open 30 min. Rec. 10' mud 0#
DST 3191-3250 open 20 min. Rec. 30'
vsocm Cong. 3414 TD 3453

D & A

J. G. McGEHEE