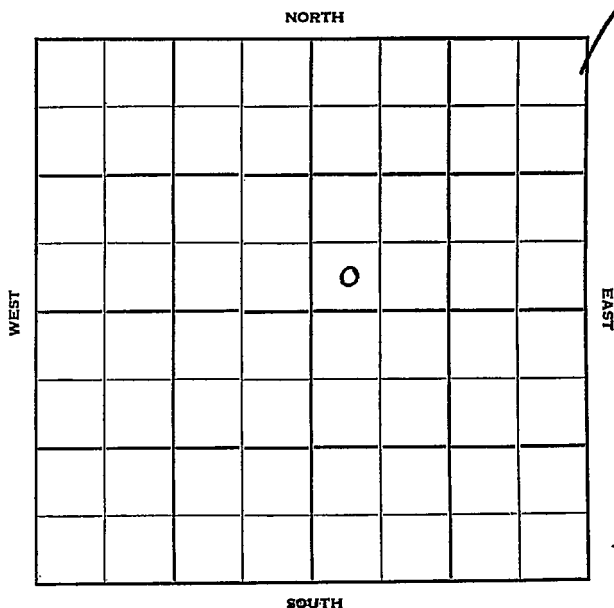


Section 28 . Township 19 Range 16 WWell No. # 1 ThalheimCompany Courtney Davis

Rush

KANSAS


Sec. 28 Twp. 19 R. 16WWell No. #1 Thalheim FarmCourtney Davis Company

Rine

Contractor

 Ft. from N. Line330 Ft. from S. Line Ft. from E. Line330 Ft. from W. Line

SW SW NE

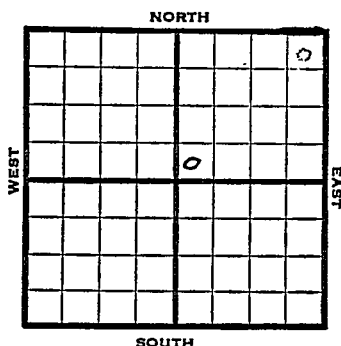

1952 Elev. 2062' REPORT

3/12 Spud 3-8-52
8" @ 1129' WOC

3/19 Drlg. 3525'

3/25 Arb. 3737' TD 3797' 5" @ 3792'

4/1 No report

4/9 Heeb. 3380 Br li 3448
Lan. 3459 Arb. 3737
DP DD 3798 TD 500 A
S/8 BOPH for 16 hrs. POP

4/23 NR

4/30 "

5/7 "

5/14 "

5/21 "

5/28 Spud 3-8-52 Oil Well TD 3798'
8" @ 1129' Heeb. 3380 Br Li 3448
Lans. 3459 Arb. 3737
TD 3798 5" @ 3792' 500 A S/ 8 boph
Comp. F/ 33 bopd

COMPLETED

County **Rush** State **Kansas**

Sec. **28** (Blk. **19** (Sur. **16W** Map No.

Operator Courtney Davis

Well No. **1** Farm **Thalheim**

Elev.	Location	SW	SW	NE
-------	----------	----	----	----

0

330 Ft. From **S** Line **NE**

530 Ft. From **W** Line Quarter

1st. Report MAR 12 1952

Completion

Remarks **Magnolia - F.O.**

Spudding Date **3-8-52**

Drig. Data	Ring
------------	------

8" @ 1129 WOC

~~J. G. McGEHEE~~

County Rush State Kansas

Sec. 28 (Blk. Twp.) 19 (Sur. Rge.) 16W Map No.

Operator Courtney Davis

Well No. 7 Farm Thalheim

Elev.	2062	Location	SW SW NE
-------	------	----------	----------

330 Ft. From S Line NE

330 Ft. From W Line Quarter

1st. Report

Completion MAY 28 1952

Remarks	Ryan Pool
---------	-----------

Spudding Date 3-8-52

Drilg. Data Oil well TD 3798

8" @ 1129 Heeb. 3380 Br. lime 3448

Lans. 3459 Arb. 3737 TD 3798

5" @ 3792 500 A S/ 8 boph

Comp. F/ 33 bopd