

Section 28 Township 19 Range 16W

Well No. #3 Christianson

Company Campbell & Kuhn

NORTH

10

WEST

EAST

				○					

SOUTH

Rush

KANSAS

Sec. 28 Twp. 19 R. 16W

Well No. #3 Christianson Farm

Campbell & Kuhn Company

Contractor


330 Ft. from N. Line

_____ Ft. from S. Line

_____ Ft. from E. Line

330 Ft. from W. Line

NW NW SE

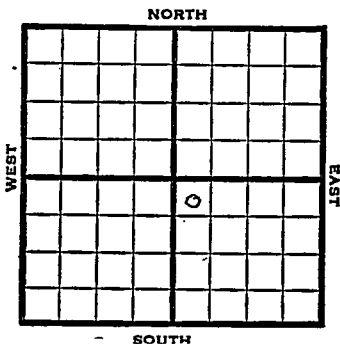

1952 Elev. 2055' REPORT

1/2 Spud 12-8-51
8" @ 1109'
Arb. 3718
Drlg. 3775'

2/6 TD 3786' 5" @ 3780 POP

2/13 No report

2/20 "

3/5 Spud 12-8-51
Oil well TD 3786' 8" @ 1109'
Arb. 3718' TD 3786' 5" @ 3780'
CO to 3786' S/1½ BOPH 4 hr.
1000 A S/5 BOPH
Comp. 100 BOPD

COMPLETED

