


Section 29 Township 19 Range 11W

Well No. #1 Mellies Est.

Company Keys Drlg.

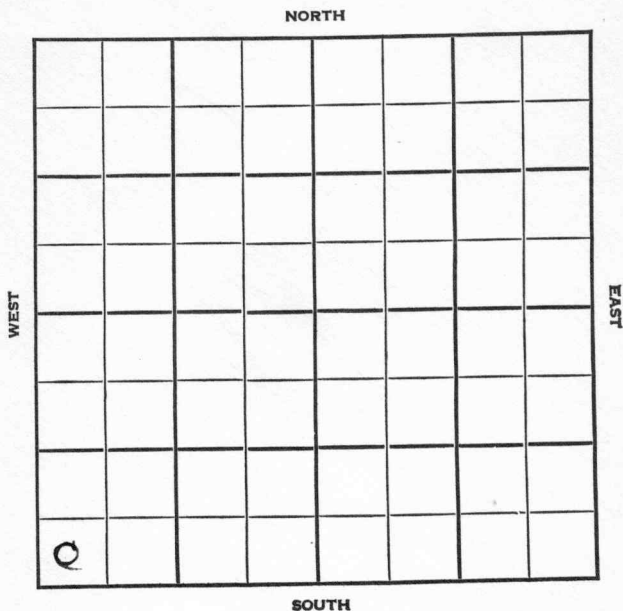

Sec. 29 **KANSAS** Twp. 19 Barton R. 11-W

Well No. #1 Mellies Est. Farm

Keyes Drlg. Company

Wildcat


 Ft. from N. Line

330' Ft. from S. Line

 Ft. from E. Line

330' Ft. from W. Line

SW/C

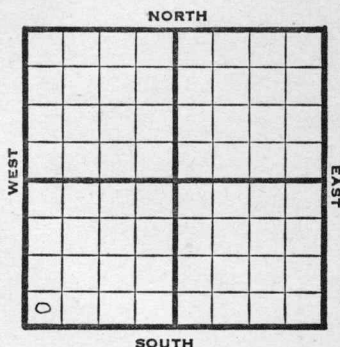

1947

Elev. 1788' REPORT

12/10

Loc.

12/30

Lans. 3095'

Arb. 3358'

TD 3393'

ABANDONED

Map No. _____ Sec. 29 Twp. 19 R. 11W

Well No. 1 Mellies Est.

Keyes Drlg.


Company _____

FIRST REPORT

Contractor _____

SW/C

SECTION PLAT

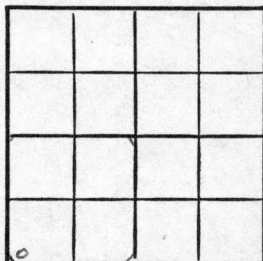

_____ Ft. from N. Line

330 Ft. from S. Line

_____ Ft. from E. Line

330 Ft. from W. Line

Barton County

Location X

Rig up _____

Drilling and Remarks:

RECORD

Cased _____ in., _____ ft.

Sand _____

Gas _____

Oil _____

Total Depth _____

PRODUCTION

1st 24 hrs. Nat. _____

1st 24 hrs. after shot _____

Gas _____ Cu. Ft.

Dry Hole _____

Abandoned _____

Date

DEC 10 1947

19

S. J. LEWIS

Scout

