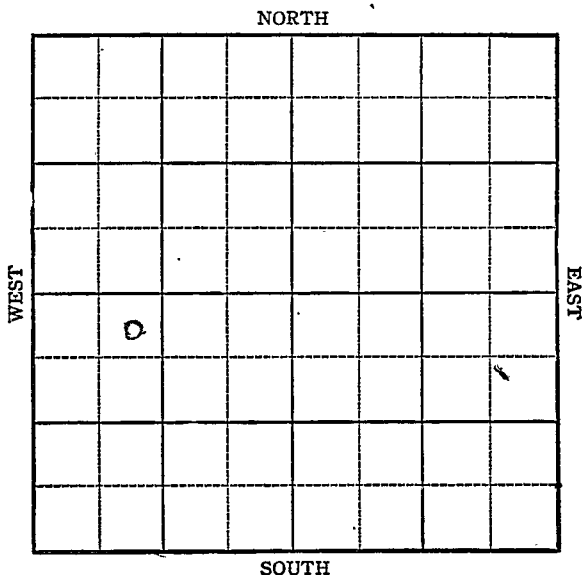


KANSAS

Rice

Section 29 Township 19 Range 10WWell No. #3 Bayer "A"Company Nadel & Gussman

KANSAS

Rice

Sec. 29 Twp. 19 R. 10W

Well No. #3 Bayer "A" Farm

Nadel & Gussman Company


Silica

330 Ft. from N. Line

 Ft. from S. Line

 Ft. from E. Line

990 Ft. from W. Line

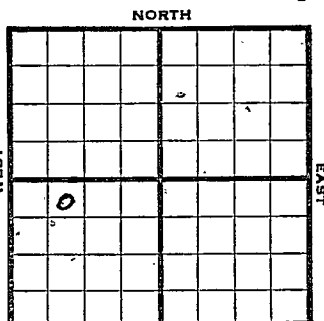

NE NW SW Elev. 1796 SOUTH

1945

R E P O R T

2/14	Location
2/21	R U R
2/28	"
3/7	8" @ 161 Drlg 2320
3/14	Topeka 2850 Lans 3014 Arb 3337-39 TD 5" @ 3337 RUST
3/23	" " "
3/29	TD 3345 500 acid. Swb 3/4 oil PH
4/5	20 shots 3337-3345 1000 a id 2500' fluid 75% wtr. Cong 3301 12 shots 3324-3330 48 shots 3301-3310 Plug 3188 12 shots 3104-3111 CO
4/12	2500 acid. 1 1/4 fluid PH
4/20	TD 3345
4/27	" "
5/3	" "
5/10	" "
5/17	" "
5/24	" "
5/31	" "
6/8	" "

OVER

1945

6/20

Lans 3014

Arb. 3337

5" @ 3337

TD 3345'

Perf. Lans 2500 acid.

Pump 25 Pot.

Grav. 41.9

COMPLETED

Pool Name SilicaMap No. K-46 Sec. 29 Twp. 19 R. 10WWell No. 3 Bayer "A"Nadel & Gussman

Company

FIRST REPORT

Contractor

NE NW SW

SECTION PLAT

330

Ft. from N. Line

Ft. from S. Line

Ft. from E. Line

990

Ft. from W. Line

Rice

o			

Location X

Rig up

Drilling and Remarks:

RECORD

Cased _____ in., _____ ft.

Sand _____

Gas _____

Oil _____

Total Depth _____

PRODUCTION

1st 24 hrs. Nat. _____

1st 24 hrs. after shot _____

Gas _____ Cu. Ft.

Dry Hole _____

Abandoned _____

Date

FEB 14 1945

19

S. J. LEWIS

Scout

1 lb. Small Maps	<i>LR</i>
Cards	<i>Beatty</i>
Trading	<i>Beatty</i>
France Map	
Scarborough Map	<i>LR</i>
Flora Map	<i>Beatty</i>
Catalogue Dept.	
Plat Book	

Kansas Pool Name SilicaMap No. _____ Sec. 29 Twp. 19 R. 10WWell No. 3 Bayer "A"Nadel & Gussman

Company

COMPLETED

Contractor

NE NW SW


E 1, 1796

SECTION PLAT

330 Ft. from N. Line

_____ Ft. from S. Line

_____ Ft. from E. Line

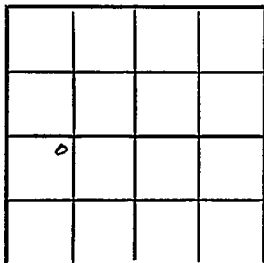990 Ft. from W. LineRice County

Location _____

Rig up _____

Drilling and Remarks:

Li. and 3014Cr Y 33375" @ 3337Perf. hole.2500 acid.Pump 25 Pot41 1/2 Sec.

Date

RECORD

Cased _____ in., _____ ft.

Sand _____

Gas _____

Oil _____

Total Depth 3345**PRODUCTION**

1st 24 hrs. Nat. _____

1st 24 hrs. after shot _____

Gas _____ Cu. Ft.

Dry Hole _____

Abandoned _____

JUN 20 1945 19S. J. LEWIS Scout

Willow Creek Maps

Cards *ROB*

Tracing _____

France Map _____

Scarborough Map *Rob*

Pierce Map _____

Geological Dept. _____

Pierce Plat Book _____