


Section 29 Township 19 Range 10W

Well No. #5 Boyer

Company West Supply

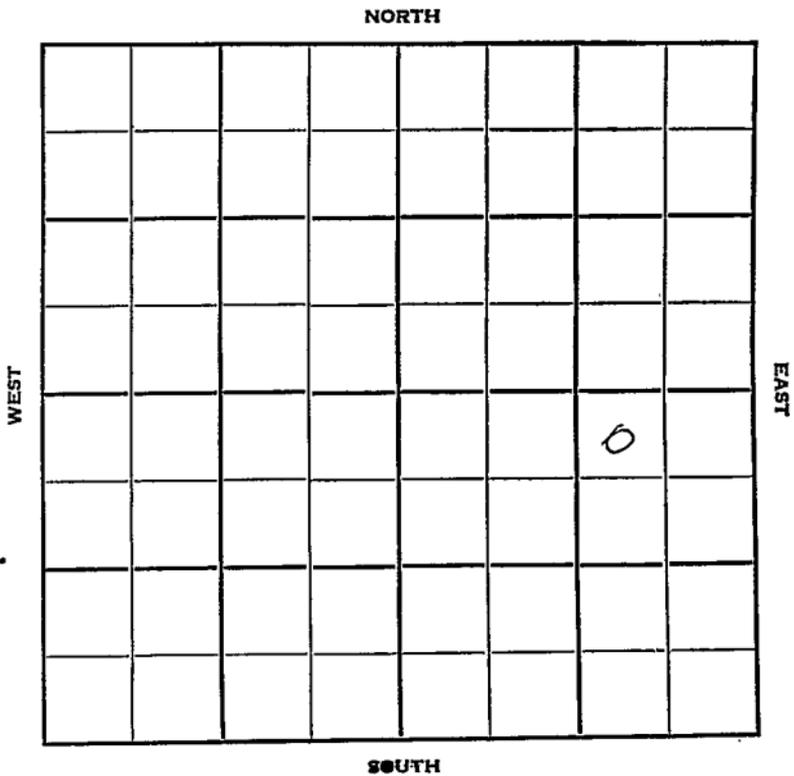

Sec. 29 Twp. 19 R. 10 W ✓

Well No. # 5 Boyer Farm

West Supply Company

Contractor

Silica Pool


330 Ft. from N. Line

Ft. from S. Line

1130 Ft. from E. Line

Ft. from W. Line

NW NE SE

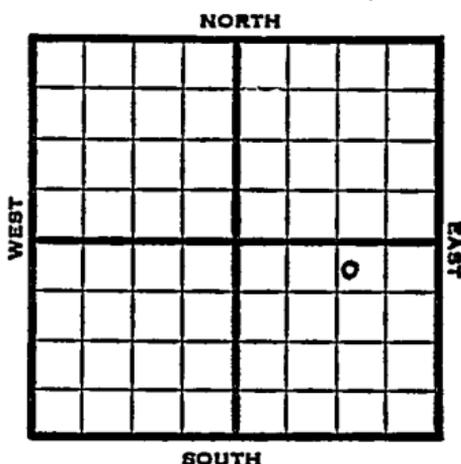

1951

Elev. 1790' REPORT

3/14

Spud 3-9-51
8" @ 217'
Anhy 480'
Drlg. 1868'

5/2

Spud 3-9-51
Oil Well TD 3337
8" @ 217'
Anhy 480 Heeb. 2846
Dodge 2907
DST 2908-80 opn 1/2 hr
Rec. 20' socm Br Lime 2966
Lans. 2987 SO 3018-21 3085-92
DST 3080-3100 opn 1/2 hr
Rec. 55' o & gem SO 3177-82
Arb. 3272 TD 3337
11/3275-79 5" @ 3337
12/3284-88 12/3292-95 1000 A
Comp. 60 bopd

COMPLETED

