


Section 29 Township 19 Range 10W

Well No. #4 Bayer (B)

Company West Supply

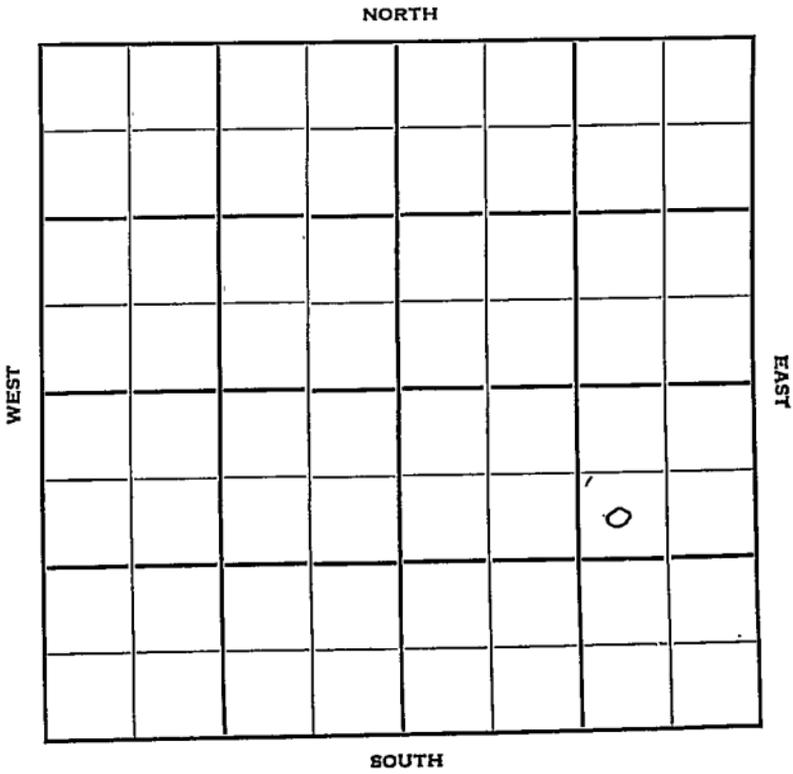

Rice

KANSAS

Sec. 29 Twp. 19 R. 10 W

Well No. # 4 Bayer (B) Farm

West Supply Company

Stagg Drlg. Contractor

Silicia Pool


990 Ft. from N. Line

\_\_\_\_\_ Ft. from S. Line

990 Ft. from E. Line

\_\_\_\_\_ Ft. from W. Line

SW NE SE

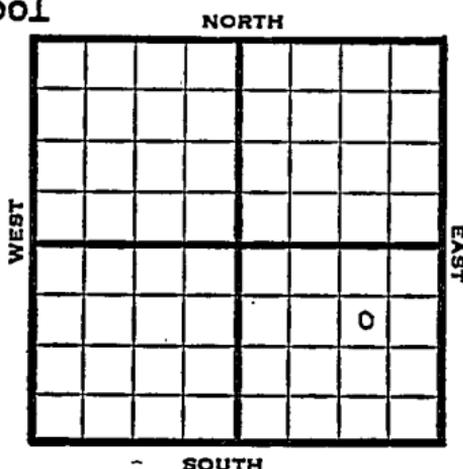

1951

Elev. 1780' REPORT

9/19

Spud 9-12-51  
8" @ 190' Anhy 447'  
Drlg. 2635'

10/24

Spud 9-12-51  
Oil Well TD 3283  
8" @ 190  
Anhy 447 Heeb. 2838  
Br. lm. 2957 Ians. 2973  
DST 3004-16 open 1 hr.  
Rec. 2700' gas 200' G&OCM  
40' wtr.  
DST 3161-76 open 1/2 hr.  
Rec. 30' SGCM  
Arb. 3273-76  
5" @ 3274 TD 3283  
Comp. 60 BOPD 40 % wtr.

**COMPLETED**



