

Section 29 Township 19 Range 10 W

Well No. # 1 Bayer (C)

Company J. Kornfeld West Supply Co

NORTH

WEST

EAST

SOUTH

Rice

KANSAS ✓

Sec. 29 Twp. 19 R. 10 W

Well No. # 1 Bayer (C) Farm
West Supply Co.
J. Kornfeld Company

Lewis Contractor

Silicia


Ft. from N. Line

990 Ft. from S. Line

1080 Ft. from E. Line

Ft. from W. Line

NW SE SE

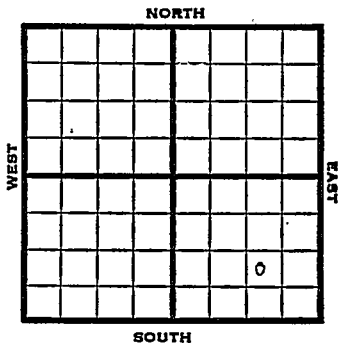

1951

Elev. 1787' REPORT

7/11

Heeb 2854' Br. L 2972' Lans 2993'
DST 3085-97' 45 min.

8/22

Oil Well TD 3313
Heeb. 2854 Br lime 2972
Lans. 2993
DST 3085-97 opn 45 min.
Rec. 50' mud & SSO
Cong. 3285 Simp 3297
Arb. 3310 TD 3313
5" @ 3310 FU 2200' oil
Comp. 35 bopd

COMPLETED

County **Rice** State **Kansas**

Sec. 29 (Blk.) 19 (Sur.) 10W Map No.

Operator **J. Kornfeld**

Well No. 1 Farm Bayer (C)

Elev. 1787 Location NW SE SE

FIRST REPORT

990 Ft. From S Line SE

1080 Ft. From E Line Quarter

1st. Report **JUL 11 1951**

Completion

Remarks

Lewis - Contractor

Spudding Date "


Drlg. Data **Silicia - pool**

Heeb 2854 Br L 2972 Lens 2993 DST 3085-97

45 min.

J. E. TYRA.

County Rice State Kansas
 Sec. 29 (Blk.) 19 (Sur.) 10W Map No.
 Operator J. Kernfeld West Supply Co.
 Well No. 1 Farm Bayer "C"
 Elev. 1787 Location NW SE SE

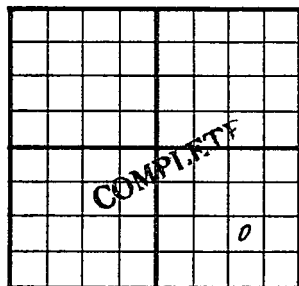

990 Ft. From S Line SE
1080 Ft. From E Line Quarter
 1st. Report
 Completion AUG 22 1951
 Remarks Silica Pool
Lewis Drlg. - Contr.
 Spudding Date

Drlg. Data Oil well TD 3313
Heeb. 2854 Br. line 2972 Lans. 2993
DST 3085-97 open 45 min. Rec. 50' mud &
SSO Cong. 3285 Simp. 3297 Arb. 3310
TD 3313 5" @ 3310 FU 2200' oil
Comp. 35 bopd

J. E. TYRA