


Rice KANSAS

Section 29 Township 19 Range 10 W
 Well No. # 2 Bayer "E"
 Company West Supply Co.

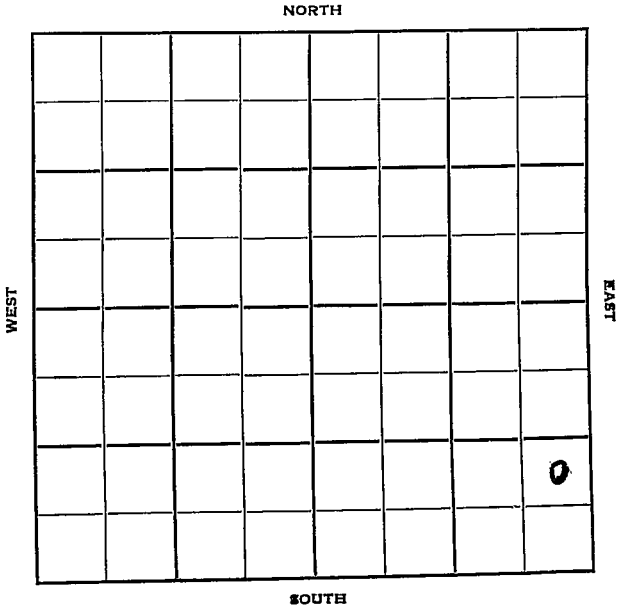

KANSAS ✓

Sec. 29 Twp. Rice R. 19 10W

Well No. #2 Bayer "C" Farm

West Supply Co. Company

Contractor

Ft. from N. Line

990


Ft. from S. Line

330

Ft. from E. Line

Ft. from W. Line

NE SE SE

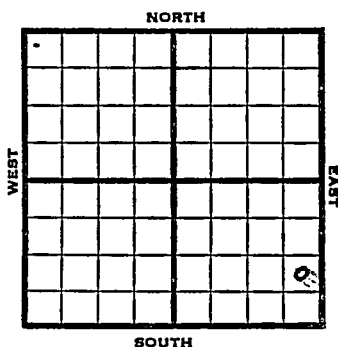

1952

Elev. 1776

REPORT

11/26 Spud 11-24-52
8" @ 242'

12/3 Anhy 430, Heeb 2835, Tor 2852,
Douglas 2867, SO 2880-2904 &
2910-26, Br li 2953, Lans 2963,
SO 3000-3007 & 3102-73, Cong.
3266, Arb. 3272
RTD 3275
5" @ 3275

12/11 NR

12/18 NR

12/25 NR

1/1 DD 3280 TD 1 BOPH 1500A 1 BOPH

1/8 NR

1/22 P/4 BOPD

1/29 NR

2/5 "

2/12 DD 3283'

OVER

1953

2/18

Spudding Date 11/24/52

Oil Well TD 3283

8" @ 242 Anhy 430 Heeb. 2835

Tor. 2852 Doug. 2867 SO 2880-

2904 2910-26 Br. lime 2953 Lans.

2963 SO 3000-07 3162-73 Cong. 3266

Arb. 3272 VSSO 3272-75 TD 3275 5"

@ 3275 DD 3280 S/1 boph 500A 1000A

S/1 boph P/4 bopd DD 3283

500 A Comp. 24 bopd

COMPLETED

J. G. McGEHEE

Scout Cards

Land Small Map

Land Wall Map

Tracings

France Map


Pierce Map

Misc.

NOV 28 1952

Drig. Data

County Rice State Kansas
 Sec. 29 (Blk. 19) (Sur. 10W) Map No. _____
 Operator West Supply Co.
 Well No. 2 Farm Bayer "C"
 Elev. 1776 Location NE SE SE

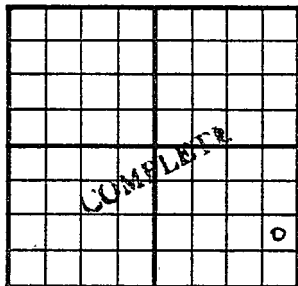

990 Ft. From S Line SE
330 Ft. From E Line Quarter
 Ist. Report _____
 Completion FEB 18 1953
 Remarks _____
 Spudding Date 11-24-52

Drilg. Data Oil well TD 3283
8" @ 242 Anhy 430 Heeb. 2835
Tor. 2852 Doug. 2867 SO 2880-2904
2910-26 Br. lime 2953 Lans. 2963
SO 3000-07 3162-73 Cong. 3266
Arb. 3272 VSSO 3272-75 TD 3275
5" @ 3275 DD 3280 S/ 1 boph 500 A
1000 A S/ 1 boph P/ 4 bopd DD 3283
500 A Comp. 24 bopd

Scout Cards	SS
Land Small Map	
Land Wall Map	3
Tracings	
France Map	
Ice Map	
Use	

FEB 24 1953