

KANSAS


Rice

FORM 51 5M 1-42 PETROL

Section 29 Township 19 Range 10-W

Well No. #1 Bayer

Company Nadel & Gussman

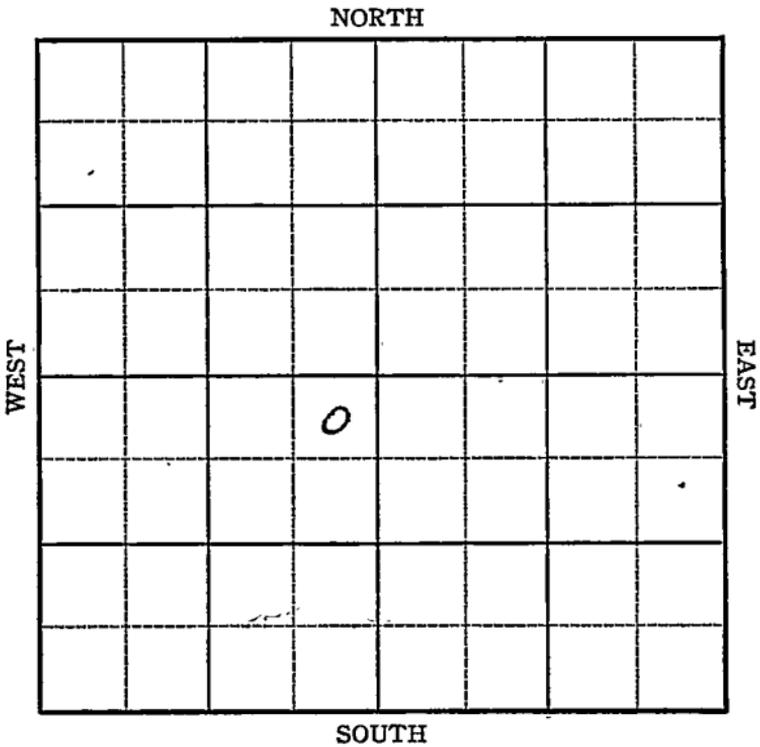

Sec. 29 Twp. 19 R. 10-W

Well No. #1 Bayer Farm
Nadel & Gussman Company


330 Ft. from N. Line

_____ Ft. from S. Line

330 Ft. from E. Line

_____ Ft. from W. Line

Elev. 1794

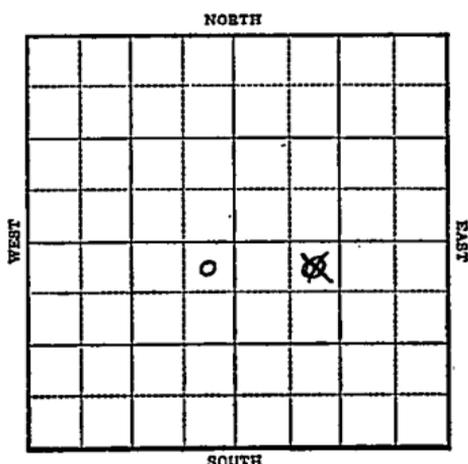

1943

R E P O R T

11/10

Rotary

11/17

8" @ 200
WOC

11/24

Drlg 2655'

12/1

Lans 3005
Arb 3273
TD 3281

5" @ 3275 1200' oil 2-hrs.

12/8

No arb.
Cong 3279
TD 3286 in cong
1000 acid
Pump 2 oil per hr. 9 hrs.

12/15

5" @ 3275
Congl 3279
1000 acid
Pump 50 Pot.
TD 3286
Gravi 46

COMPLETED

KANSAS
 Map No. 46 Sec. 29 Twp. 19 R. 10W

Well No. 1 Bayer

Nadel & Gussman Company

FIRST REPORT

Contractor

NE SW

SECTION PLAT

330 Ft. from N. Line

_____ Ft. from S. Line

330 Ft. from E. Line

_____ Ft. from W. Line

		o	

Doran Pool

Location _____

Rig up _____

Drilling and Remarks:

Rotary

RECORD

Cased _____ in., _____ ft.

Sand _____

Gas _____

Oil _____

Total Depth _____

PRODUCTION

1st 24 hrs. Nat. _____

1st 24 hrs. after shot _____

Gas _____ Cu. Ft.

Dry Hole _____

Abandoned _____

Date

NOV 10 1943 19

S. J. LEWIS Scout

Rice

KANSAS

Map No. 46 Sec. 29 Twp. 19 R. 10W

Well No. 1 Bayer

Nadel & Gussman Company

COMPLETED Contractor

NE SW

SECTION PLAT

330 Ft. from N. Line

_____ Ft. from S. Line

330 Ft. from E. Line

_____ Ft. from W. Line

Doran Pool

Location _____

Rig up _____

Drilling and Remarks:

*Comp 3279
5" @ 3275
1000 cu ft
Pump 50 ft*

46-1/2

RECORD

Cased _____ in., _____ ft.

Sand _____

Gas _____

Oil _____

Total Depth 3287

PRODUCTION

1st 24 hrs. Nat. _____

1st 24 hrs. after shot _____

Gas _____ Cu. Ft.

Dry Hole _____

Abandoned _____

Date

DEC 15 1943 19

S. J. LEWIS Scout