


Section 29 Township 19 Range 10-W

Well Number #1-Bayer

Company Shell

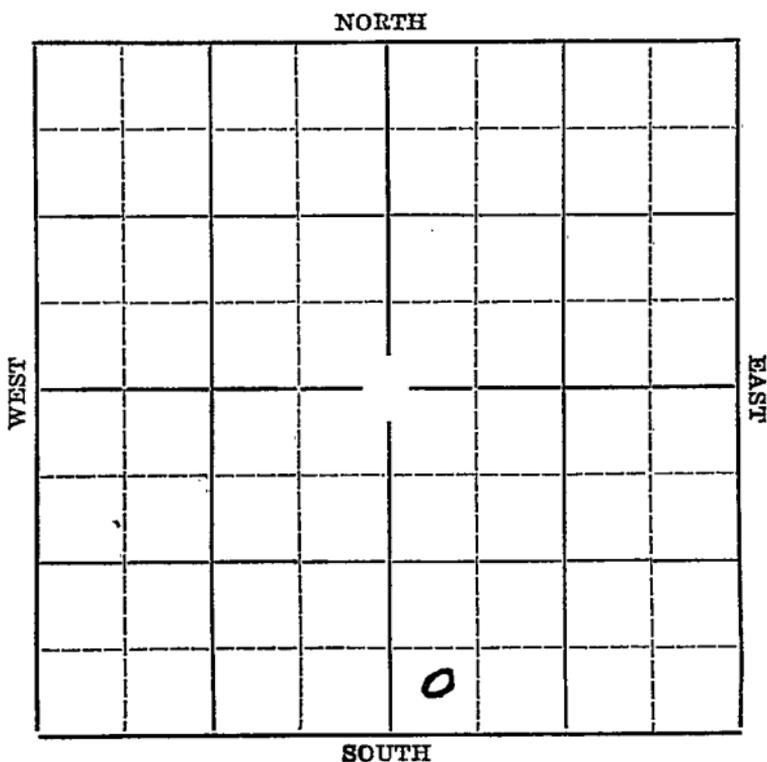

Sec. 29 Twp. 19 R. 10W

Well No. #1 Bayer Farm
Shell Company


_____ Ft. from N. Line

330' Ft. from S. Line

_____ Ft. from E. Line

330' Ft. from W. Line

Elev. 1788

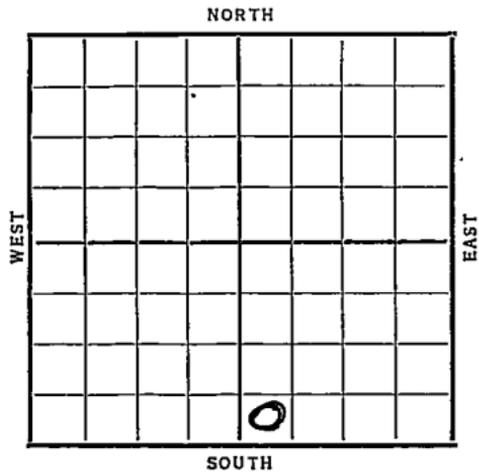

Date	REPORT
1936	
9/23	Rigging up.
10/1	--
10/8	12" @ 193'. Drlg. 647'.
10/15	Drlg. 2257'.
10/22	Lansing 3005'. Drlg. 3055'.
10/29	Sil. 3282'. TD 3287'. running
	7" to 3283'.
11/6	T. D. 3297 No test
11/12	1000 acid 141 oil 350 water 12
	hrs. pump.
11/19	---
11/27	Plug back 3292'. 30 bbls. oil
	120 bbls. water. 20 hrs.
12/3	Shut down.
12/10	" " 12/17--
12/22	Sil. 3282'. T. D. 3297'.
	P.B. 3292'.
	Pump 35 bbls. oil 235 water.
	COMPLETED

KANSAS

Form 26—1M Bks.—2-29

Map No. 55 Sec. 29 Twp. 19 R. 10W.

Well No. 1 Bayer

Shell Co. Company

Contractor

SECTION PLAT

_____ Ft. from N. Line

330 Ft. from S. Line

_____ Ft. from E. Line

330 Ft. from W. Line

FIRST REPORT

Location _____

Rig up _____

Drilling and Remarks:

Rigging up.
SJL

RECORD

Cased _____ in., _____ ft.

Sand _____

Gas _____

Oil _____

Total Depth _____

PRODUCTION

1st 24 hrs. Nat. _____

1st 24 hrs. after shot _____

Gas _____ Cu. Ft.

Dry Hole _____

Abandoned _____

Date

SEP 23 1936 19

S. J. LEWIS Scout