


Section 29 Township 19 Range 10W

Well No. # '2 Roth

Company Stanolind

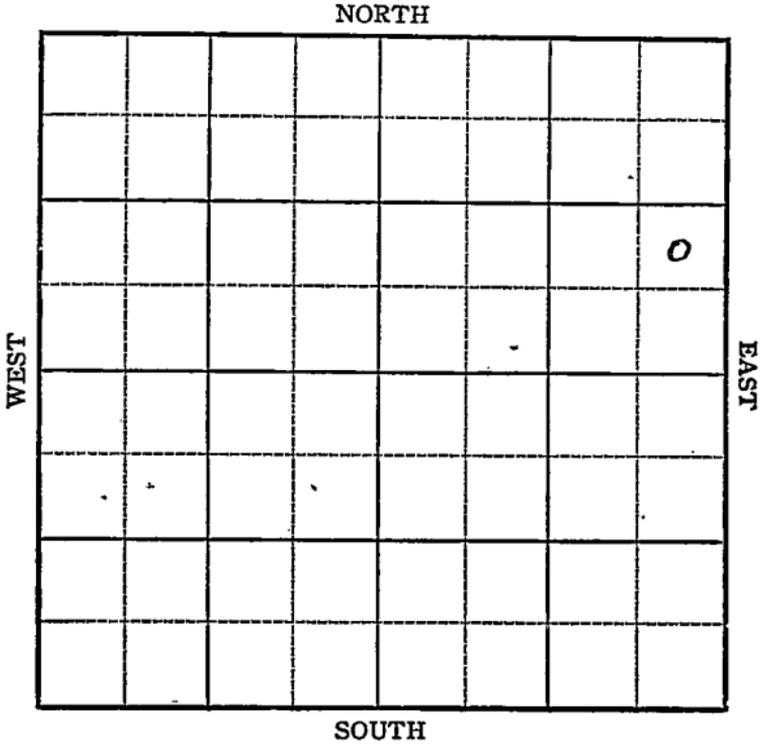


Sec. 29 Twp. 19 R. 10-W

Well No. #2 Roth Farm

Stanolind Company

NORTH

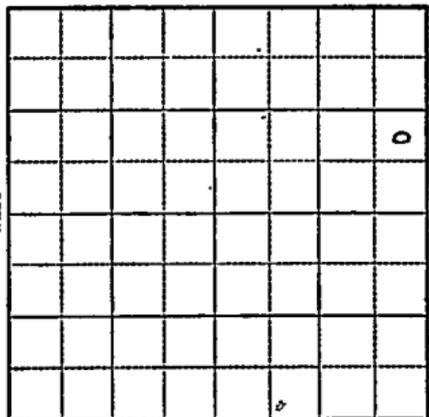

\_\_\_\_\_ Ft. from N. Line

990 Ft. from S. Line

330 Ft. from E. Line

\_\_\_\_\_ Ft. from W. Line

Elev. 1772

1944

R E P O R T

2/2

8" @ 224  
WOC.

2/8

Drig. 2605'

2/16

Lans 2991  
Drig. 3228

2/23

Arb 3293  
TD 3338 $\frac{1}{2}$

Map No. 4/6 <sup>1/2</sup> SAS Sec. 29 Twp. 19 R. 10W

Well No. 2 RothStanolind

Company

## FIRST REPORT

Contractor

NE SE NE

## SECTION PLAT

			o
			✓

\_\_\_\_\_ Ft. from N. Line

990 Ft. from S. Line330 Ft. from E. Line

\_\_\_\_\_ Ft. from W. Line

Silica Pool

Location \_\_\_\_\_

Rig up \_\_\_\_\_

Drilling and Remarks:

8" - 224 WOC

## RECORD

Cased \_\_\_\_\_ in., \_\_\_\_\_ ft.

Sand \_\_\_\_\_

Gas \_\_\_\_\_

Oil \_\_\_\_\_

Total Depth \_\_\_\_\_

## PRODUCTION

1st 24 hrs. Nat. \_\_\_\_\_

1st 24 hrs. after shot \_\_\_\_\_

Gas \_\_\_\_\_ Cu. Ft.

Dry Hole \_\_\_\_\_

Abandoned \_\_\_\_\_

Date

FEB 2 1944 19S. J. LEWIS Scout

Map No. KANSAS 710 Sec. 29 Twp. 19 R. 10W

Well No. 2 Roth

Stanolind Company

ABANDONED Contractor

NE SE NE

SECTION PLAT

			o

\_\_\_\_\_ Ft. from N. Line

990 Ft. from S. Line

330 Ft. from E. Line

\_\_\_\_\_ Ft. from W. Line

Silica Pool

Location \_\_\_\_\_

Rig up \_\_\_\_\_

Drilling and Remarks:

*Car X 9293*

RECORD

Cased \_\_\_\_\_ in., \_\_\_\_\_ ft.

Sand \_\_\_\_\_

Gas \_\_\_\_\_

Oil \_\_\_\_\_

Total Depth 335 1/2

PRODUCTION

1st 24 hrs. Nat. \_\_\_\_\_

1st 24 hrs. after shot \_\_\_\_\_

Gas \_\_\_\_\_ Cu. Ft.

Dry Hole \_\_\_\_\_

Abandoned \_\_\_\_\_

Date

FEB 23 10 A M 19

S. J. LEWIS Scout