

Section 29 Township 19 Range 10WWell No. #5 RothCompany Stanolind

NORTH

							0

WEST

EAST

SOUTH

Rice KANSAS



Sec. 29 Twp. 19 R. 10 W

Well No. # 5 Roth Farm

Stanolind Company

Contractor


330 Ft. from N. Line

 Ft. from S. Line

330 Ft. from E. Line

 Ft. from W. Line

NE NE NE

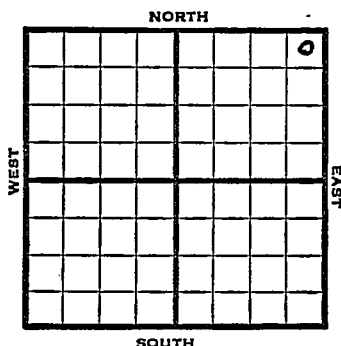

1952

Elev. 1773'

REPORT

8/6

Location

8/13

"

8/20

8" @ 452
Anhy 443'
Drlg. 2652'

8/27

Lans. 2981
DST 3056-83 3/4 hr. 95' GCM 95' SW
670# DST 3154-67 1 hr. 20' M
20' M 200 # Arb. 3269
DST 3269-74 1 hr. 10' M 0#
DST 3274-79 1 hr. 35' M
& SO 740# DST 3277-84 1/2 hr.
780' clean Oil 700#

9/4

Spud 8-13-52
Oil Well TD 3284'
Anhy 443 8" @ 452 Lans. 2981
DST 3056-83 open 3/4 hr. rec. 95' gcm
95' sw 670#
DST 3154-67 open 1 hr. rec. 20' mud
200 # Arb. 3269
DST 3269-74 open 1hr. rec. 10' mud 0#
DST 3474-79 open 1 hr. rec. 35' mud
& SO 740#
DST 3277-84 open 1/2 hr. rec. 780'
clean oil 700# 5" @ 3282 CO to 3284
S/ 17 boph 500 A S/ 20 boph
Comp. 480 bopd

COMPLETED

J. G. McGEHEE

County Rice State Kansas
 Sec. 29 (Blk. 19 (Sur. 10W Map No. 19)
 Operator Stanolind
 Well No. 5 Farm Roth
 Elev. 1773 Location NE NE NE

330 Ft. From N Line NE

330 Ft. From E Line Quarter

1st. Report

Completion SEP 4 1952

Remarks

Spudding Date 8-13-52

Drig. Data Oil well TD 3284

Anhy 443 8" @ 452 Lans. 2981

DST 3056-83 open 3/4 hr. Rec. 95' gom

95' sw 670# DST 3154-67 open 1 hr.

Rec. 20' mud 200# Arb. 3269

DST 3269-74 open 1 hr. Rec. 10' mud 0#

DST 3274-79 open 1 hr. Rec. 35' mud & S

740# DST 3277-84 open 1/2 hr. Rec. 780

clean oil 700# 5" @ 3282 CO to 3284

S/ 17 boph 500 A S/ 20 boph

Comp. 480 bopd

J. G. McGEHEE