


Map No. KANSAS Sec. 29 Twp. 19 R. 9W

Well No. 2 Grove Farm \_\_\_\_\_  
Empire Oil Company

*Rice*

NORTH

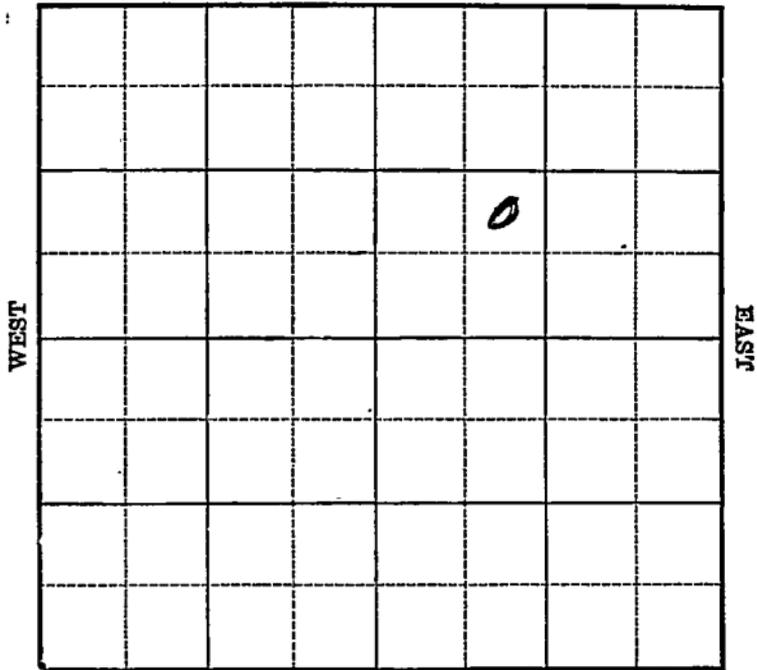

SOUTH

Location \_\_\_\_\_

Drilling Remarks \_\_\_\_\_

\_\_\_\_\_

\_\_\_\_\_

Rig Up \_\_\_\_\_

Drilling Remarks \_\_\_\_\_

\_\_\_\_\_

\_\_\_\_\_

**RECORD**

Cased \_\_\_\_\_ in. \_\_\_\_\_ ft.

Sand \_\_\_\_\_

Gas \_\_\_\_\_

Oil \_\_\_\_\_

Total Depth \_\_\_\_\_

**PRODUCTION**

1st 24 hrs. Nat. \_\_\_\_\_

1st 24 hrs. after shot \_\_\_\_\_

Gas \_\_\_\_\_ cu. ft.

Dry Hole \_\_\_\_\_


Abandoned \_\_\_\_\_

*Rice*

Map No. KANSAS Sec. 29 Twp. 19 R. 9<sup>W</sup>

Well No. 2 Grove Farm  
Empire Oil Company

\_\_\_\_\_ Ft. from N. Line  
990 Ft. from S. Line  
\_\_\_\_\_ Ft. from E. Line  
990 Ft. from W. Line

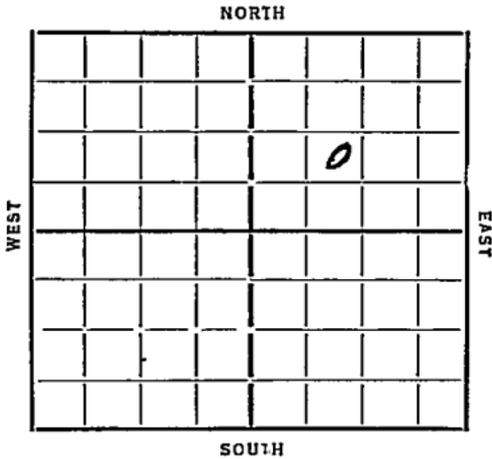

Date	REPORT
<u>1/16</u>	<u>Location</u>
<u>1/24</u>	<u>Cellar</u>
<u>1/31</u>	<u>_____</u>
<u>2/7</u>	<u>Rgn Rot</u>
<u>2/14</u>	<u>slg 1685</u>
<u>2/21</u>	<u>" 2694</u>
<u>2/28</u>	<u>8" 3185 WOC</u>
<u>3/7</u>	<u>_____</u>
<u>3/14</u>	<u>Siliceous 3200 50' 6" liner</u> <u>3215 TD 2200 oil 1000 acid</u>
<u>3/20</u>	<u>Siliceous 3200 TD 3215</u> <u>1000 acid 1774 Bbls.</u>

**COMPLETED**

Map No. 49 Sec. 29 Twp. 19 R. 9W

Well No. 2-Move

Empire Oil Company

Contractor

**FIRST REPORTS**

**SECTION PLAT**

Ft. from N. Line

990 Ft. from S. Line

Ft. from E. Line

990 Ft. from W. Line

		0	

Location ✓

Rig up

Drilling and Remarks:

**RECORD**

Cased.....in., .....ft.

Sand.....

Gas.....

Oil.....

Total Depth.....

**PRODUCTION**

1st 24 hrs. Nat.....

1st 24 hrs. after shot.....

Gas.....Cu. Ft.

Dry Hole.....

Abandoned.....

Date

1-16-35 192.....

**ORVAL MANSCHRECK**

Scout

Form 26-1M Bls. 9-28

Map No. 49 Sec. 29 Twp. 19 R. 9W

Well No. 2 - Brown

Empire Oil Company

Contractor

**COMPLETED**

**SECTION PLAT**

		0	

..... Ft. from N. Line

990 Ft. from S. Line

..... Ft. from E. Line

990 Ft. from W. Line

**RECORD**

Location.....

Rig up.....

Drilling and Remarks:

1000 acid

1724 bbls

Cased..... in., ..... ft.

Sand silicon 3200

Gas.....

Oil.....

Total Depth 3215

**PRODUCTION**

1st 24 hrs. Nat.....

1st 24 hrs. after shot.....

Gas..... Cu. Ft.

Dry Hole.....

Abandoned.....

Date

3-20-34

192.....

**ORVAL MANNSCHRECK**

Scout