



Rice

Map No. KANSAS Sec. 29 Twp. 19 R. 9W

Well No. 2-Grove Farm  
Marathon Oil Company


NORTH

330 Ft. from N. Line

Ft. from S. Line

330 Ft. from E. Line

Ft. from W. Line

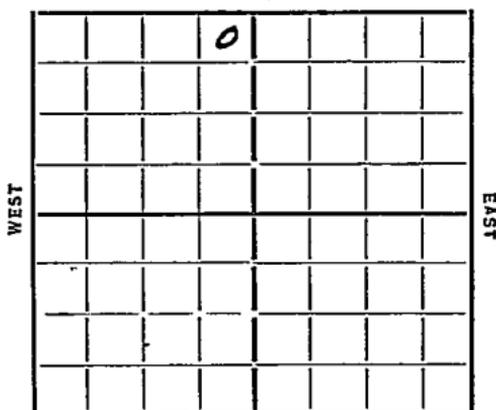

SOUTH

Date 1925

REPORT

4/8 Bldg Rig  
4/14 Rig  
4/18 Dlg 450 20" 121  
4/26 " 1610 15" 709  
5/2 " 2300 10" 2225  
5/9 " 2820  
5/16 8" 3012 50 3194-3200  
 Sil ~~3220~~ 3206  
5/23 Sil 3206 Corrupted  
 6" 3236 S.O. 3245  
 Pay 3257-61 T7 3275  
 2600 Oil  
5/29 3275 T7 1000 acid  
 262 Bbls May Super  
6/6 3286 T7 Reading  
6/13 Cem Back 3275  
6/20 — 6/28 — 7/3 —  
7/10 Sil 3206 T7 3286  
 PA 3275 165 Bbls

COMPLETED

KANSAS

Form 26-1M Bks. 9-28

Map No. 49 Sec. 29 Twp. 19 R. 9W

Well No. 2 - Grove

Marathon oil Company

Contractor

**FIRST REPORTS**

330 Ft. from N. Line

..... Ft. from S. Line

330 Ft. from E. Line

..... Ft. from W. Line

**SECTION PLAT**

	0		

Location.....

Rig up.....

Drilling and Remarks:

Bldg Rig

**RECORD**

Cased..... in., ..... ft.

Sand.....

Gas.....

Oil.....

Total Depth.....

**PRODUCTION**

1st 24 hrs. Nat.....

1st 24 hrs. after shot.....

Gas..... Cu. Ft.

Dry Hole.....

Abandoned.....

Date

4-3-35 192.....

**ORVAL MANNSCHRECK**

Scout

KANSAS

Form 26-1M Bks. 9-26

Map No. 49 Sec. 29 Twp. 19 R. 9W

Well No. 2-Brove

Marathon Oil Company

Contractor

COMPLETION

SECTION PLAT

	0		

330 Ft. from N. Line

..... Ft. from S. Line

330 Ft. from E. Line

..... Ft. from W. Line

Location .....

Rig up .....

Drilling and Remarks:

P.B. 3275

165 lbs

RECORD

Cased.....in., .....ft.

Sand Sil 3206

Gas.....

Oil.....

Total Depth 3286

PRODUCTION

1st 24 hrs. Nat.....

1st 24 hrs. after shot.....

Gas.....Cu. Ft.

Dry Hole.....

Abandoned.....

Date

7-10-35 192

**AL MANN SCHRECK**

Scout