

Map No. **KANSAS** Sec. 29 Twp. 19 R. 9WWell No. T-Grave FarmTexas Co. Company

NORTH

WEST

EAST

SOUTH

Location _____

Drilling Remarks _____

RECORD

Cased _____ in. _____ ft.

Sand _____

Gas _____

Oil _____

Total Depth _____

Rig Up _____

Drilling Remarks _____

PRODUCTION

1st 24 hrs. Nat. _____

1st 24 hrs. after shot _____

Gas _____ cu. ft.

Dry Hole _____

Abandoned _____

Rice


Map No. KANSAS Sec. 29 Twp. 19 R. 9W
Well No. 7 Grove Farm
Texas Co. Company

990 Ft. from N. Line

_____ Ft. from S. Line

_____ Ft. from E. Line

330 Ft. from W. Line

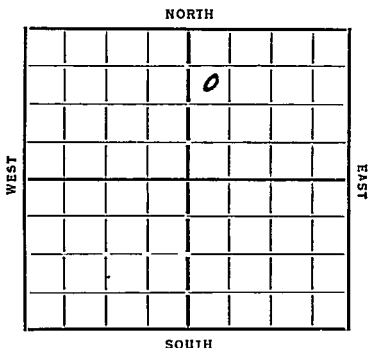

Date 1935

REPORT

2/27 Cellar

3/7 Rgn

3/14 Blk 2415 12" 150

3/21 Sil 3210 T 3212

8" 3211 Rust

3/28 _____

4/3 Siliceous 3208

T 3222.

1121 Blk.

COMPLETED

Map No. 49 Sec. 29 Twp. 19 R. 9WWell No. 7 - GroveTexas Co Company

Contractor

FIRST REPORTS

990 Ft. from N. Line

Ft. from S. Line

Ft. from E. Line

330 Ft. from W. Line

SECTION PLAT

		0	

Location

Rig up

Drilling and Remarks:

Clear

RECORD

Cased.....in.,ft.

Sand.....

Gas.....

Oil.....

Total Depth.....

PRODUCTION

1st 24 hrs. Nat.....

1st 24 hrs. after shot.....

Gas.....Cu. Ft.

Dry Hole.....

Abandoned.....

Date

2-27-35 192

ORVAL MANNSCHRECK

Scout

KANSAS

Form 28—1M Bks. 9-28

Map No. 49 Sec. 29 Twp. 19 R. 9NWell No. 7-GroveTexas Co Company

Contractor

CORRECTED

SECTION PLAT

990 Ft. from N. Line

Ft. from S. Line

Ft. from E. Line

330 Ft. from W. Line

		0	

Location

Rig up

Drilling and Remarks:

RECORD

Cased _____ in., _____ ft.

Sand silicious 3208

Gas _____

Oil _____

Total Depth 3222

PRODUCTION

1st 24 hrs. Nat. _____

1st 24 hrs. after shot _____

Gas _____ Cu. Ft.

Dry Hole _____

Abandoned _____

Date

ORVAL MANNSCHRECK

4-3-35 192

Scout