


DX 78-1

Section 29 Township 19 Range 9W
Well No. 3-A Service Grove
Cities Service
Company _____

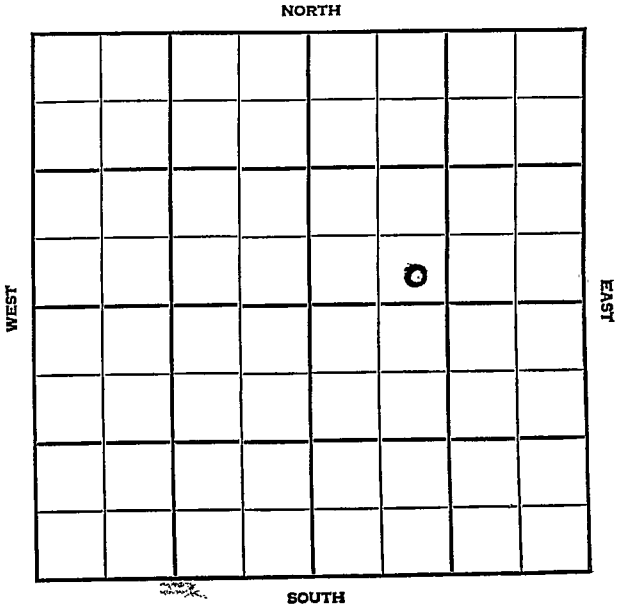

Rice KANSAS

SEC.	TWP.	R.
29	19	9W

WELL NO.

3-A Grove

FARM

COMPANY

Cities Service

CONTRACTOR

Brack


Chase-Silica Pool

_____ Ft. from N. Line

390 _____ Ft. from S. Line

_____ Ft. from E. Line

1220 _____ Ft. from W. Line

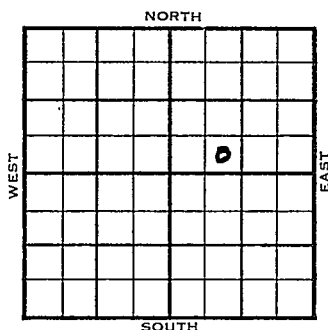

SE SW NE SWDW

	ELEVATION	REPORT
1954	1718'	

8/4 Spdg 7-30-54

8" @ 178

drlg. 1407

9/15 SWDW Well

TD 3705'

8" @ 178'

Plans 2906', Arb. 3206'

TD 3301'

5" @ 3300'


DD 3705'

Comp. SWD Well

Input 192 BWPH

ABANDONED

County Rice State Kansas
 Sec. 29 (Blk.
Twp.) 19 (Sur.
Rge.) 9W Map No.
 Operator Cities Service
 Well No. 3-A Farm Grove
 Elev. 1718 Location SE SW NE

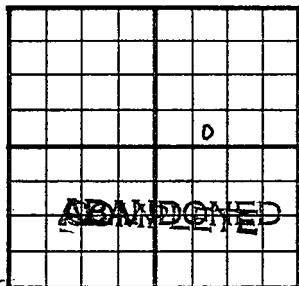

390 Ft. From S Line NE
1220 Ft. From W Line Quarter
 Ist. Report
 Completion SEP 15 1954
 Remarks SWDW

Spudding Date

Drlg. Data SWDW well TD 3705
8" @ 178 Lans. 2906 Arb. 3206
TD 3301 5" @ 3300 DD 3705
Comp. SWD well Input 192 bwph

FABEN GILSTRAP