


Section 29 Township 19 Range 9-W

Well No. 3 Grove


Company B. F. Stapleton

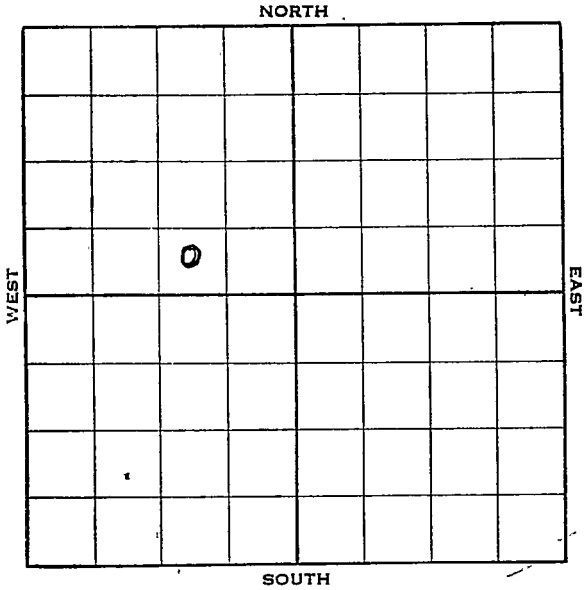

Sec. 29 Twp. 19 R. 9-W

Well No. #3 Grove Farm
B. F. Stapleton Company

 Ft. from N. Line
330 Ft. from S. Line
990 Ft. from E. Line
 Ft. from W. Line

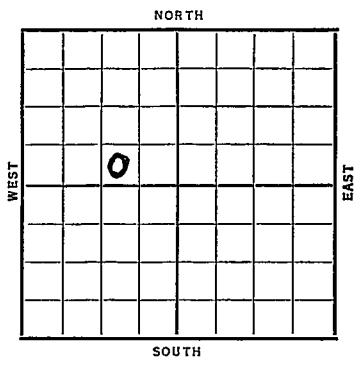

Elev. 1722

Date	REPORT
1938	
7/27	15" - 125'. 12" - 760'. Dlg. 1300'.
8/5	10" - 1770'. T.D. 2222'. Rng. 8".
8/12	8" - 2235'. Lans. 2908'. S. O. 2918-23'.
8/19	Arb. 3208-23'. 7" - 3209'.
8/24	7" at 3209'. Arb. 3208'. T. D. 3223'. Pump 298 bbls. 4 hrs. & 284 bbls 4 hours. Potential 1705 bbls. No water.
	COMPLETED

Rice KANSAS

Map No. 49 Sec. 29 Twp. 19 R. 9W

Well No. 3 Grove

B. F. Stapleton Company
(Formerly Keith et al)
 Contractor

FIRST REPORT

SW SE NW

 Ft. from N. Line

330 Ft. from S. Line

990 Ft. from E. Line

 Ft. from W. Line

SECTION PLAT

	0		

Location

Rig up

Drilling and Remarks:

~~RUC~~
 15" - 125
 12" - 760
 Dlg 1300

RECORD

Cased in., ft.

Sand

Gas

Oil

Total Depth

PRODUCTION

1st 24 hrs. Nat.

1st 24 hrs. after shot

Gas Cu. Ft.

Dry Hole

Abandoned

Date

JUL 27 1938

19

H. D. Hatfield Scout

Map No. 49 Sec. 29 Twp. 19 R. 9WWell No. 3 GroveB. F. Stapleton Company

Contractor

COMPLETED

SW SE NW

_____ Ft. from N. Line

330 Ft. from S. Line990 Ft. from E. Line

_____ Ft. from W. Line

SECTION PLAT

	0		

Location _____

Rig up _____

Drilling and Remarks:

P- 298/4 + 284/4

POT 1705

No water

RECORD

Cased 7 in., 3209 ft.Sand Arb 3208

Gas _____

Oil _____

Total Depth 3223

PRODUCTION

1st 24 hrs. Nat. _____

1st 24 hrs. after shot _____

Gas _____ Cu. Ft.

Dry Hole _____

Abandoned _____

Date

AUG 24 1938

19

H. D. Hatfield Scout