


Rice

Form 51-5M-5-34-Palace

Map No. **KANSAS** Sec. 29 Twp. 19 R. 9W

Well No. 2 Grove Farm
Keith et al Company

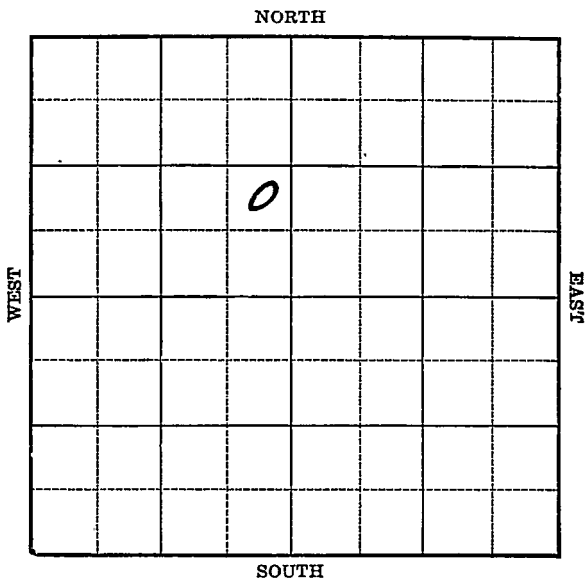

Location _____

Drilling Remarks _____

Rig Up _____

Drilling Remarks _____

RECORD

Cased _____ in. _____ ft.

Sand _____

Gas _____

Oil _____

Total Depth _____

PRODUCTION

1st 24 hrs. Nat. _____

1st 24 hrs. after shot _____

Gas _____ cu. ft.

Dry Hole _____


Abandoned _____

Rice

Map No. KANSAS Sec. 29 Twp. 19 R. 9W

Well No. 2 Grove Farm
Keith et al Company

_____ Ft. from N. Line
990 Ft. from S. Line
330 Ft. from E. Line
_____ Ft. from W. Line

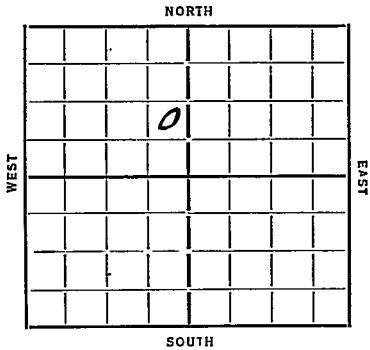

Date 1934 REPORT

11/14 *locating*
11/27 *— 11/28 — 12/6 —*
12/13 *Ponds*
12/21 *Moving in*
12/27 _____
1/3/35 *Rig*
1/10 _____
1/17 *Rgn*
1/24 *Dlg 320*
1/31 *" 1300 15" 327.*
2/7 *" 2105 13" 1772*
2/14 *" 2700 10" 2225*
2/21 *" 3165*
2/28 *6" 3200 s.o.*
3/6 *Siliceous 3230 TD 3251*
1016 Bbl.

COMPLETED

Map No. 49 Sec. 29 Twp. 19 R. 9W

Well No. 2 - Grove
Keith et al Company

Contractor

FIRST REPORTS

SECTION PLAT

_____ Ft. from N: Line

990 Ft. from S. Line

330 Ft. from E. Line

_____ Ft. from W. Line

	0		

Location ✓

Rig up _____

Drilling and Remarks:

RECORD

Cased _____ in., _____ ft.

Sand _____

Gas _____

Oil _____

Total Depth _____

PRODUCTION

1st 24 hrs. Nat. _____

1st 24 hrs. after shot _____

Gas _____ Cu. Ft.

Dry Hole _____

Abandoned _____

Date

11-14-34 19

ORVAL MANNSCHRECK

Scout

Map No. 49 Sec. 29 Twp. 19 R. 9W

Well No. 2 - Brown
Keith etal Company

Contractor

COMPLETED

SECTION PLAT

..... Ft. from N. Line

990 Ft. from S. Line

330 Ft. from E. Line

..... Ft. from W. Line

	o		
		.	

Location.....

Rig up.....

Drilling and Remarks:

RECORD

Cased..... in., ft.

Sand silicious 32-30

Gas.....

Oil.....

Total Depth 3251

PRODUCTION

1st 24 hrs. Nat.....

1st 24 hrs. after shot.....

Gas..... Cu. Ft.

Dry Hole.....

Abandoned.....

1016 bbls

Date

ORVAL MANNSCHRECK

3-6-35 192.....

Scout