


Map No. KANSAS Sec. 29 Twp. 19 R. 9WWell No. 4 Grove FarmTruss Co. Company

NORTH

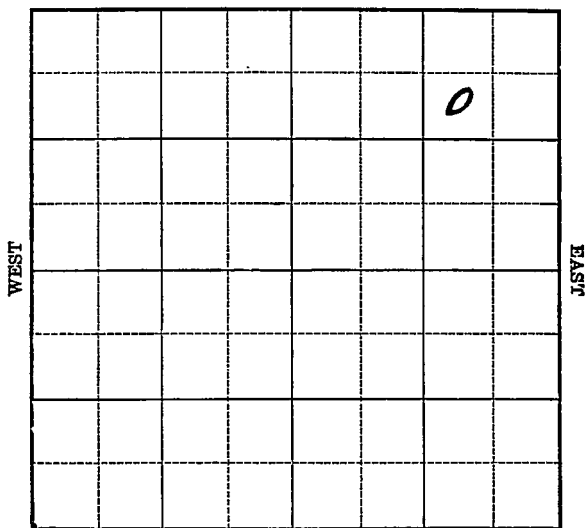

SOUTH

Location _____

Drilling Remarks _____

Rig Up _____

Drilling Remarks _____

RECORD

Cased _____ in. _____ ft.

Sand _____

Gas _____

Oil _____

Total Depth _____

PRODUCTION

1st 24 hrs. Nat. _____

1st 24 hrs. after shot _____

Gas _____ cu. ft.

Dry Hole _____


Abandoned _____

990 Ft. from N. Line

Ft. from S. Line

990 Ft. from E. Line

Ft. from W. Line

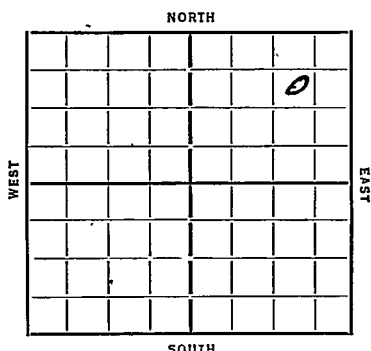

Date 7/25

REPORT

1/2 Rotary Ring
1/0 —

11/17 Bly 1339 15" 158

1/24 "V 2805

1/31. Sil 3194- 8" pipe TD 3198
2/7 11

4/11	Qty cement
------	------------

2/13 Siliceous #194 T1 #203

1141 Bld

COMPLETED

Map No. 49 Sec. 29 Twp. 19 R. 9WWell No. 4 - GroveTexas Co Company

Contractor

FIRST REPORTS

SECTION PLAT

990 Ft. from N. Line Ft. from S. Line990 Ft. from E. Line Ft. from W. Line

			0

Location Rig up

Drilling and Remarks:

Rotary Rig

RECORD

Cased in., ft.Sand Gas Oil Total Depth

PRODUCTION

1st 24 hrs. Nat. 1st 24 hrs. after shot Gas Cu. Ft.Dry Hole Abandoned

Date

ORVAL MANNSCHRECK

1-2-35 192 Scout

KANSAS

Map No. 49 Sec. 29 Twp. 19 R. 9WWell No. 4 - GroveTexas Company Company

Contractor

COMPLETED

SECTION PLAT

990 Ft. from N. Line

Ft. from S. Line

990 Ft. from E. Line

Ft. from W. Line

			0

Location

Rig up

Drilling and Remarks:

1141 bbl

RECORD

Cased _____ in., _____ ft.

Sand 3194

Gas _____

Oil _____

Total Depth 3203

PRODUCTION

1st 24 hrs. Nat. _____

1st 24 hrs. after shot _____

Gas _____ Cu. Ft.

Dry Hole _____

Abandoned _____

Date

ORVAL MANNSCHRECK

2-13-35 192 _____ Scout