


Rice

Form 51-5M-5-34-Palace

Map No. **KANSAS** Sec. 29 Twp. 19 R. 9W

Well No. 2y Grove Farm
Lyons Co. Company

NORTH

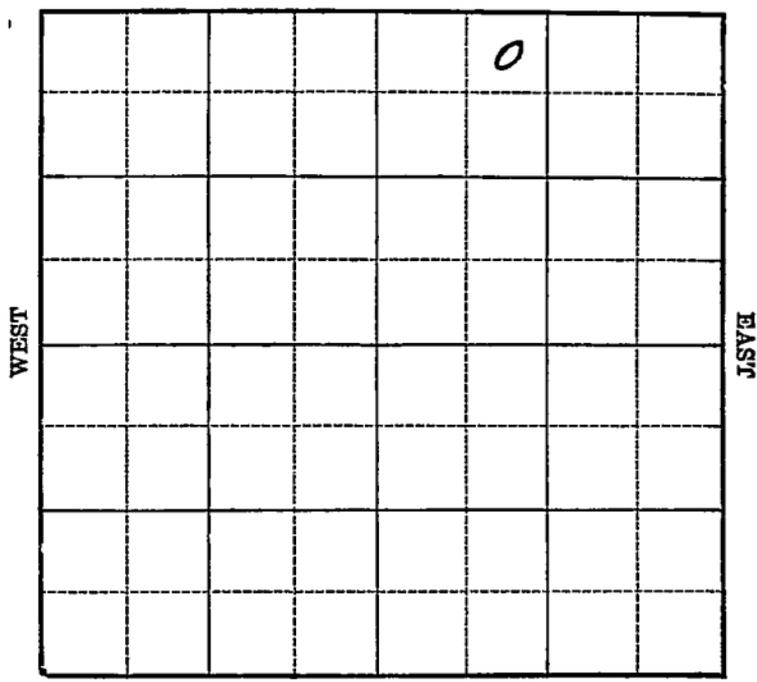

SOUTH

Location _____

Drilling Remarks _____

Rig Up _____

Drilling Remarks _____

RECORD

Cased _____ in. _____ ft.

Sand _____

Gas _____

Oil _____

Total Depth _____

PRODUCTION

1st 24 hrs. Nat. _____

1st 24 hrs. after shot _____

Gas _____ cu. ft. _____

Dry Hole _____

Abandoned _____

Rice

Map No. KANSAS Sec. 29 Twp. 19 R. 9 W


Well No. 2 Grove Farm
Lynn Co. Company

330 Ft. from N. Line

_____ Ft. from S. Line

_____ Ft. from E. Line

990 Ft. from W. Line

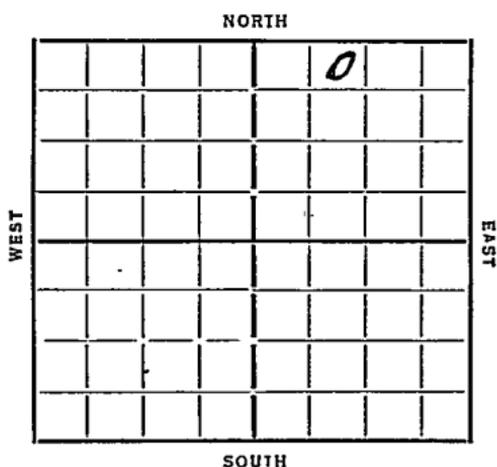

Date 1924

REPORT

- 11/14 Ponds
- 11/22 M.O. G.
- 11/28 Rot. Rig
- 12/6 12" 153 WOC
- 12/13 Slg 1995
- 12/21 " 3134
- 12/27 Siliceous 3197 TD 3203 Rust
- 1/3/35
- 1/10 P 765 Bbls 24 hrs.
- 1/16 Siliceous 3197 TD 3208
974 Bbls.

COMPLETED

Map No. 49 Sec. 29 Twp. 19 R. 9W

Well No. 2 - Grove

Texas Co Company

Contractor

FIRST REPORTS

SECTION PLAT

330 Ft. from N. Line

_____ Ft. from S. Line

_____ Ft. from E. Line

990 Ft. from W. Line

		0	

Location _____

Rig up _____

Drilling and Remarks:

Ronds

RECORD

Cased _____ in., _____ ft.

Sand _____

Gas _____

Oil _____

Total Depth _____

PRODUCTION

1st 24 hrs. Nat. _____

1st 24 hrs. after shot _____

Gas _____ Cu. Ft.

Dry Hole _____

Abandoned _____

Date

11-14-34 19

ORVAL MANNSCHRECK

Scout

Map No. 49 Sec. 29 Twp. 19 R. 9W

Well No. 2 - Grove

Texas Co Company

Contractor

COMPLETED

SECTION PLAT

330 Ft. from N. Line

..... Ft. from S. Line

..... Ft. from E. Line

990 Ft. from W. Line

		0	

Location.....

Rig up.....

Drilling and Remarks:

974 bbb

RECORD

Cased 31 in., ft.

Sand Silicium 3197

Gas.....

Oil.....

Total Depth 3208

PRODUCTION

1st 24 hrs. Nat.....

1st 24 hrs. after shot.....

Gas..... Cu. Ft.

Dry Hole.....

Abandoned.....

Date

1-16-35 192.....

ORVAL MANN SCHRECK

Scout