



Rice


Map No. KANSAS Sec. 29 Twp. 19 R. 9<sup>w</sup>  
Well No. 1 Grove Farm  
Grove Co. Company

330 Ft. from N. Line

\_\_\_\_\_ Ft. from S. Line

990 Ft. from E. Line

\_\_\_\_\_ Ft. from W. Line

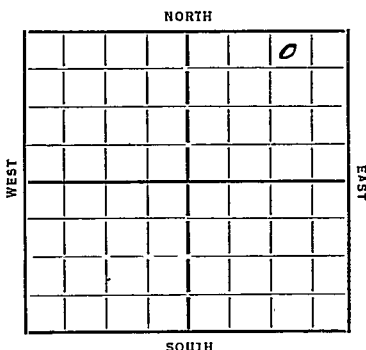

Date 7/24

REPORT

9/19 Location  
9/26 Material  
10/4 12 1/2 152 T 156 WOC  
10/11 Dly 2465  
10/18 Lancing 2910 8" 2918  
T 2923 WOC  
10/25 Rust  
11/1 Dly 3115  
11/8 698 3195 Siliceous 3185  
Pay 3194-98 HFO 12 hrs.  
11/14 Siliceous 3185  
Oil 3194-98 T 3198  
1480 Bbls Nat.

COMPLETED

KANSAS

Map No. 49 Sec. 29 Twp. 19 R. 9W

Well No. 1 - Grove  
Texas Co Company

Contractor

SECTION PLAT

			0

330 Ft. from N. Line

\_\_\_\_\_ Ft. from S. Line

990 Ft. from E. Line

\_\_\_\_\_ Ft. from W. Line

FIRST REPORTS

Location ✓

Rig up \_\_\_\_\_

Drilling and Remarks:

RECORD

Cased \_\_\_\_\_ in., \_\_\_\_\_ ft.

Sand \_\_\_\_\_

Gas \_\_\_\_\_

Oil \_\_\_\_\_

Total Depth \_\_\_\_\_

PRODUCTION

1st 24 hrs. Nat. \_\_\_\_\_

1st 24 hrs. after shot \_\_\_\_\_

Gas \_\_\_\_\_ Cu. Ft.

Dry Hole \_\_\_\_\_

Abandoned \_\_\_\_\_

Date

9-19-34 19

ORVAL MANNSCHRECK

Scout

Form 28-1M Bks 9228

Map No. 49 Sec. 29 Twp. 19 R. 9W

Well No. 1 - Grove

Texas Company Company

Contractor

**COMPLETED**

**SECTION PLAT**

330 Ft. from N. Line

..... Ft. from S. Line

990 Ft. from E. Line

..... Ft. from W. Line

			0

Location.....

Rig up.....

Drilling and Remarks:

1480 bbls  
natural

**RECORD**

Cased..... in., ..... ft.

Sand silicious 3185

Gas.....

Oil 3194-98

Total Depth 3198

**PRODUCTION**

1st 24 hrs. Nat.....

1st 24 hrs. after shot.....

Gas..... Cu. Ft.

Dry Hole.....

Abandoned.....

Date

**ORVAL MANNSCHRECK**

11-14-34 192.....

Scout