

KANSAS

Rice

Section 29 Township 19 Range 9W

Well No. 1 Layton


Company J C Dozier et al

Chase

NORTH

WEST

EAST

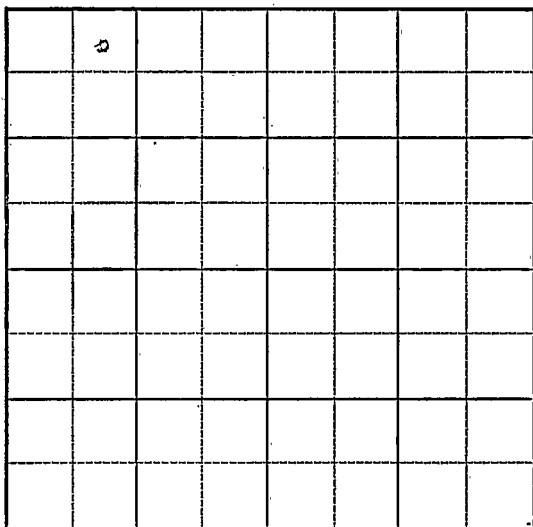

SOUTH

KANSAS

Rice

Sec. 29 Twp. 19 R. 9W ✓

Well No. #1 Layton Farm

J. C. Dozier et al Company


Chase Pool

330' Ft. from N. Line

 Ft. from S. Line

 Ft. from E. Line

990' Ft. from W. Line

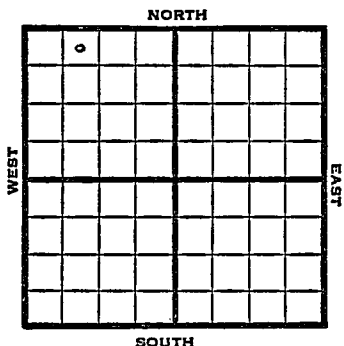

NE NW NW

1949

Elev 1721' REPORT

3/23

Location

3/30

8" @ 166'

Drlg 2470'

4/6

Arb. 3223-28'

TD 3228'

5" @ 3225

4/13

TD 3242'

Arb. 3223'

5" @ 3225'

Aband.

ABANDONED

Map No. _____ Sec. 29 Twp. 19 R. 9W

Well No. 1 Layton

J. C. Dozier et al. Company

FIRST REPORT Contractor

NE NW NW


SECTION PLAT

330 Ft. from N. Line

_____ Ft. from S. Line

_____ Ft. from E. Line

990 Ft. from W. Line

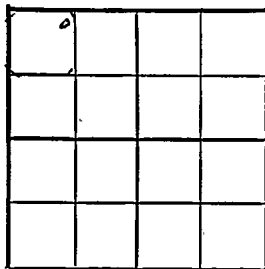

Rice County

Location X

Rig up _____

Drilling and Remarks:

RECORD

Cased _____ in., _____ ft.

Sand _____

Gas _____

Oil _____

Total Depth _____

PRODUCTION

1st 24 hrs. Nat. _____

1st 24 hrs. after shot _____

Gas _____ Cu. Ft.

Dry Hole _____

Abandoned _____

Date

MAR 23 1949 19 S. J. LEWIS Scout

Kansas

Map No. 49 Sec. 29 Twp. 19 R. 9WWell No. 1 Layton

J. C. Dozier et al.

Company

ABANDONED

Contractor

NE NW NW

*E 11721***SECTION PLAT**

6			

330 Ft. from N. Line Ft. from S. Line Ft. from E. Line990 Ft. from W. LineRice CountyLocation Rig up

Drilling and Remarks:

22423
5' C 225

RECORDCased in., ft.Sand Gas Oil Total Depth 2242**PRODUCTION**1st 24 hrs. Nat. 1st 24 hrs. after shot Gas Cu. Ft.Dry Hole Abandoned

Date

APR 13 1949 19S. J. LEWIS

Scout