


Map No. **KANSAS** Sec. 29 Twp. 19 R. 9WWell No. 5-Tourneau FarmShell Pet. Company

NORTH

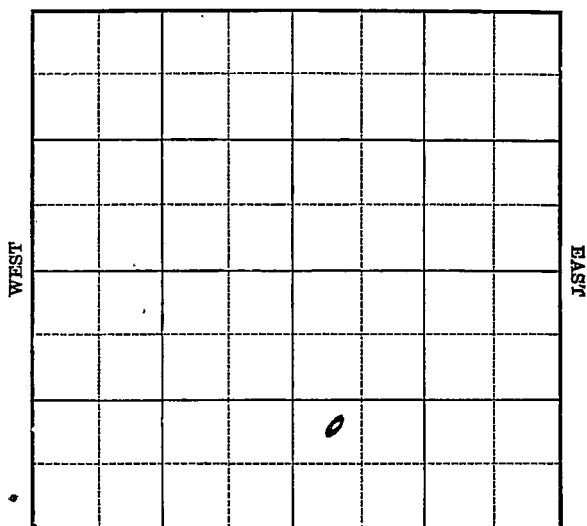

SOUTH

Location _____

Drilling Remarks _____

Rig Up _____

Drilling Remarks _____

RECORD

Cased _____ in. _____ ft.

Sand _____

Gas _____

Oil _____

Total Depth _____

PRODUCTION

1st 24 hrs. Nat. _____

1st 24 hrs. after shot _____

Gas _____ cu. ft.

Dry Hole _____

Abandoned _____

Rice


Map No. KANSAS Sec. 29 Twp. 19 R. 9W
Well No. 5-Tourneau Farm
Shell Pit. Company

 Ft. from N. Line

990 Ft. from S. Line

 Ft. from E. Line

330 Ft. from W. Line

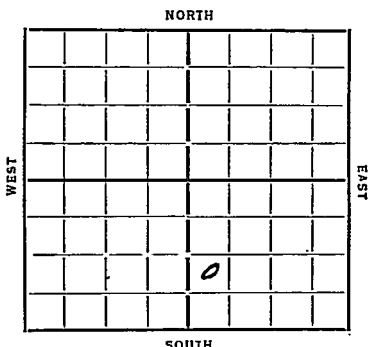

Date

REPORT

1935
4/17 Bldg
4/26 12" 155 WOC
5/7 Bldg 1526
5/9 " 2915
5/16 Sil 3228 7" 3230
T 3235 Rust
5/25 Bldg plug
5/29 Sil 3257-60 T 3274
500' oil 30 gts 1500' fluid
6/6 6000 acid
6/13 No help from acid
3319 Shs Water
6/20
6/28 S.D.
7/3 — 7/11 — 7/18 — 8/8 —
8/15 — 8/22 —
8/28 Sil 3228
T 3340

D & A.

ABANDONED

Map No. 49 Sec. 29 Twp. 19 R. 9WWell No. 5-TourneauShell pit Company

Contractor

FIRST REPORTS


Ft. from N. Line

990 Ft. from S. Line

Ft. from E. Line

330 Ft. from W. Line

SECTION PLAT

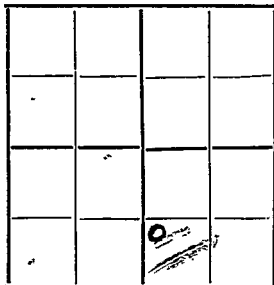

Location

Rig up

Drilling and Remarks:

Blow

RECORD

Cased in., ft.

Sand

Gas

Oil

Total Depth

PRODUCTION

1st 24 hrs. Nat.

1st 24 hrs. after shot

Gas Cu. Ft.

Dry Hole

Abandoned

Date

ORVAL MANNSCHRECK

4-17-35 192 Scout

Map No. 20 Sec. 29 Twp. 19 R. 9WWell No. 5 - TournearShell jet Company

Contractor

ABANDONED

SECTION PLAT

		0	

Ft. from N. Line

990 Ft. from S. Line

Ft. from E. Line

330 Ft. from W. Line

Location

Rig up

Drilling and Remarks:

RECORD

Cased _____ in. _____ ft.

Sand oil 3228

Gas _____

Oil _____

Total Depth 3340

PRODUCTION

1st 24 hrs. Nat. _____

1st 24 hrs. after shot _____

Gas _____ Cu. Ft.

Dry Hole _____

Abandoned _____

Date

8-28-35 192

ORVAL MANNSCHRECK

Scout