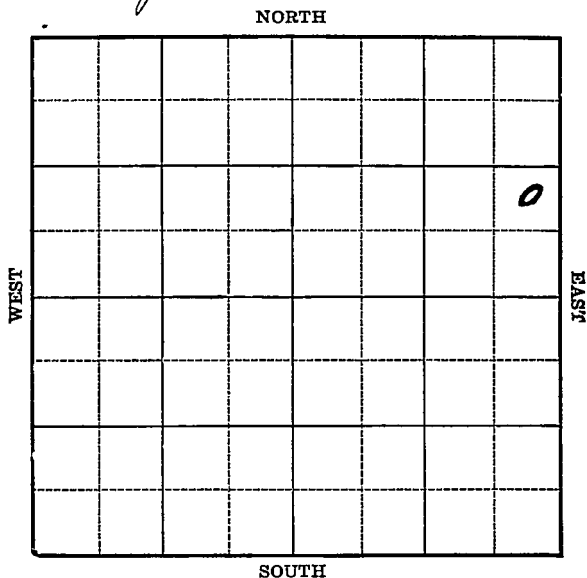


Map No. **KANSAS** Sec. **29** Twp. **19** R. **9W**Well No. **3-Tourney** Farm**Empire Oil** Company

Location _____

Drilling Remarks _____

Rig Up _____

Drilling Remarks _____

RECORD

Cased _____ in. _____ ft.

Sand _____

Gas _____

Oil _____

Total Depth _____

PRODUCTION

1st 24 hrs. Nat. _____

1st 24 hrs. after shot _____

Gas _____ cu. ft.

Dry Hole _____

Abandoned _____

Rice


Map No. KANSAS Sec. 29 Twp. 19 R. 9^W
Well No. 3- Tournear Farm
Empire Oil Company

 Ft. from N. Line

990 Ft. from S. Line

330 Ft. from E. Line

 Ft. from W. Line

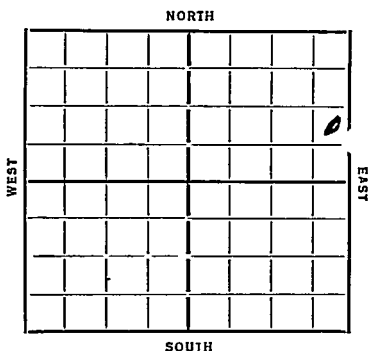

Date 1935 REPORT

5/8 Location
5/16 B R
5/23 dly 185
5/29 " 1300
6/6 " 3010
6/13 8" 3188 Rust
6/20 Hil 3208 400' oil 3218
 T 7 3234 1000 acid
6/26 Hil 3208 T 7 3234
 Pump 712 Bble

COMPLETED

Map No. 49 Sec. 29 Twp. 19 R. 9WWell No. 3-TurnerEmpire Oil Company

Contractor

FIRST REPORTS**SECTION PLAT**

			0

Ft. from N. Line

990 Ft. from S. Line330 Ft. from E. Line

Ft. from W. Line

Location ☒

Rig up

Drilling and Remarks:

RECORDCased in. 7 ft.

Sand

Gas

Oil

Total Depth

PRODUCTION

1st 24 hrs. Nat.

1st 24 hrs. after shot

Gas Cu. Ft.

Dry Hole

Abandoned

Date

ORVAL MANNSCHRECK

5-8-35 192

Scout

Map No. 49 Sec. 29 Twp. 19 R. 9W

Well No. 3 Townear

Empire Oil Company

Contractor

SECTION PLAT

Ft. from N. Line

990 Ft. from S. Line

230 Ft. from E. Line

Ft. from W. Line

COMPLETED

			0

Location

Rig up

Drilling and Remarks:

Sil 3208

Pump 7/2 off

RECORD

Cased in. ft.

Sand

Gas

Oil

Total Depth 3234

PRODUCTION

1st 24 hrs. Nat.

1st 24 hrs. after shot

Gas Cu. Ft.

Dry Hole

Abandoned

Date

6/26/35 192

ORVAL MANNSCHRECK Scout