


Rice

Map No. KANSAS Sec. 29 Twp. 19 R. 9W

Well No. 2-Tourneer Farm _____

Empire Oil Company _____

NORTH

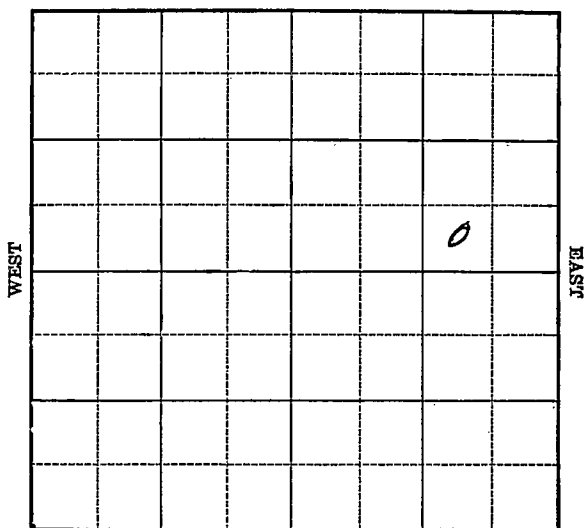

SOUTH

Location _____

Drilling Remarks _____

Rig Up _____

Drilling Remarks _____

RECORD

Cased _____ in. _____ ft.

Sand _____

Gas _____

Oil _____

Total Depth _____

PRODUCTION

1st 24 hrs. Nat. _____

1st 24 hrs. after shot _____


Gas _____ cu. ft.

Dry Hole _____

Abandoned _____

Map No. KANSAS Sec. 29 Twp. 19 R. 9a
Well No. 2- Gournier Farm
Empire Oil Company

 Ft. from N. Line
330 Ft. from S. Line
990 Ft. from E. Line
 Ft. from W. Line

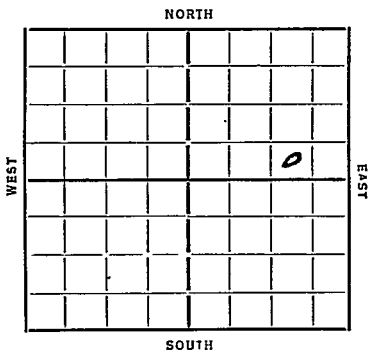

Date	REPORT
3/20	Location
3/28	Cellar
4/4	Rig
4/11	4/18-
4/26	15" 185 WOC
5/2	dlg 2015
5/9	" 2619
5/16	8" 3185 T7 3191 Rust
5/23	Ril 3201 6" 3202
5/28	T7 3220 1300' oil 1000 acid
	Ril 3201 T7 3220
	1000 acid 1376 Bbls.

COMPLETED

Form 26-1M Bks. 9-28

Map No. 49 Sec. 29 Twp. 19 R. 9WWell No. 2-TourneauEmpire oil Company

Contractor

FIRST REPORTS

SECTION PLAT

Ft. from N. Line

330 Ft. from S. Line990 Ft. from E. Line

Ft. from W. Line

			o

Location ✓

Rig up

Drilling and Remarks:

RECORD

Cased in., ft.Sand Gas Oil Total Depth

PRODUCTION

1st 24 hrs. Nat. 1st 24 hrs. after shot Gas Cu. Ft.Dry Hole Abandoned

Date

3-20-35 192ORVAL MANNSCHRECK Scout

Map No. K49 Sec. 29 Twp. 19 R. 9NWell No. 2-TourneauEmpire oil Company

Contractor

SECTION PLAT

Ft. from N. Line

330 Ft. from S. Line990 Ft. from E. Line

Ft. from W. Line

COMPLETED

			0

Location

Rig up

Drilling and Remarks:

1000 acid1376 fpls

RECORD

Cased in, ft.

Sand sl 3201

Gas

Oil

Total Depth 3220

PRODUCTION

1st 24 hrs. Nat.

1st 24 hrs. after shot

Gas Cu. Ft.

Dry Hole

Abandoned

Date

5-28-35 192

ORVAL MANNING

Scout