


Rice

Map No. _____ Sec. 29 Twp. 19 R. 9W

Well No. #1 Tournear Farm _____

Empire Oil Company _____

NORTH

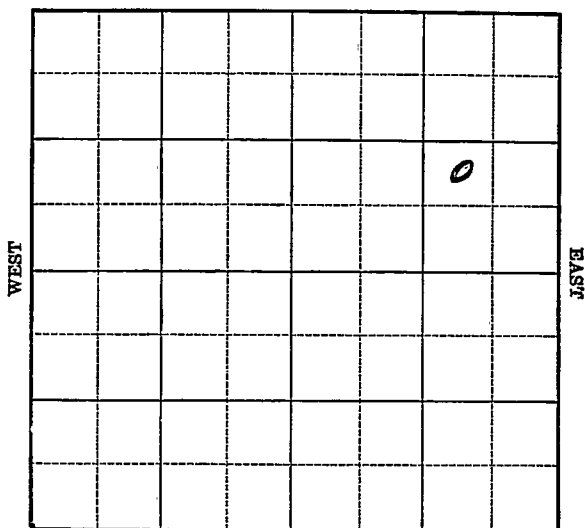

SOUTH

Location _____

Drilling Remarks _____

RECORD

Cased _____ in. _____ ft.

Sand _____

Gas _____

Oil _____

Total Depth _____

Rig Up _____

Drilling Remarks _____

PRODUCTION

1st 24 hrs. Nat. _____

1st 24 hrs. after shot _____


Gas _____ cu. ft.

Dry Hole _____

Abandoned _____

Map No. KANSAS Sec. 29 Twp. 19 R. 9W
Well No. 1 Tourneau Farm
Empire Oil Company

 Ft. from N. Line
990 Ft. from S. Line
990 Ft. from E. Line
 Ft. from W. Line

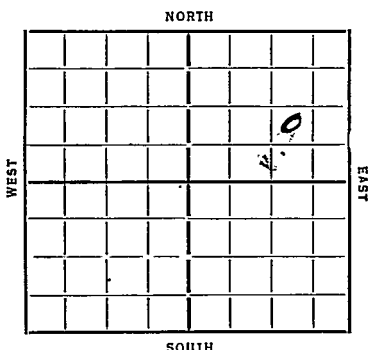

Date 1935 REPORT O. W. D. D

1/23 Pouls
1/31
2/7 Bldg Rig
2/14 Wdg 150
2/21 " 1660 15" 147
2/28 " 2645
3/7 " 3056
3/14 3185 8" cemented
3/21 Ril 3200 T 7 3213 1000 acid
3/27 Silicious 3200 T 7 3213
1000 acid 538 Bbls 21 hrs.

COMPLETED

1935 O. W. D. D

4/3 Rgn up.
4/11 3218 T 7 1900 oil Tubing
4/17 T 7 3219 1000 acid
1551 Bbls 23 hrs.

COMPLETED

Map No. 49 Sec. 29 Twp. 19 R. 9W

Well No. 1 - Tourneau

Empire Oil Company

Contractor

FIRST REPORTS

SECTION PLAT

Ft. from N. Line

990 Ft. from S. Line

990 Ft. from E. Line

Ft. from W. Line

			0

Location ✓

Rig up

Drilling and Remarks:

Sands

RECORD

Cased in., ft.

Sand

Gas

Oil

Total Depth

PRODUCTION

1st 24 hrs. Nat.

1st 24 hrs. after shot

Gas Cu. Ft.

Dry Hole

Abandoned

Date

1-23-35 192 ORVAL MANNSCHRECK Scout

Map No. 49 Sec. 29 Twp. 19 R. 9W

Well No. 1-Tourneau

Empire Oil Company

Contractor

COMPLETED

SECTION PLAT

			0

Ft. from N. Line

990 Ft. from S. Line

990 Ft. from E. Line

Ft. from W. Line

Location

Rig up

Drilling and Remarks:

1000 and

538 lpb

21 hrs

RECORD

Cased in. 3200 ft.

Sand Shale 3200

Gas

Oil

Total Depth 3213

PRODUCTION

1st 24 hrs. Nat.

1st 24 hrs. after shot

Gas Cu. Ft.

Dry Hole

Abandoned

Date

ORVAL MANN SCHRECK

3-27-35 192

Scout

Map No. 49 Sec. 29 Twp. 19 R. 9WWell No. 1-TourneauEmpire oil Company

Contractor

FIRST REPORTS

Ft. from N. Line

990 Ft. from S. Line990 Ft. from E. Line

Ft. from W. Line

OWDN

SECTION PLAT

			0

Location

Rig up

Drilling and Remarks:

OTN 3213Rig up

RECORD

Cased _____ in., _____ ft.

Sand _____

Gas _____

Oil _____

Total Depth _____

PRODUCTION

1st 24 hrs. Nat. _____

1st 24 hrs. after shot _____

Gas _____ Cu. Ft.

Dry Hole _____

Abandoned _____

Date

ORVAL MANNSCHRECK

4-3-35 192 _____ Scout

Map No. 49 Sec. 29 Twp. 19 R. 9W

Well No. 1-Tourneau

Empire Oil Company

Contractor

Completed

SECTION PLAT

			0

Ft. from N. Line

990 Ft. from S. Line

990 Ft. from E. Line

Ft. from W. Line

Location

Rig up

Drilling and Remarks:

1000 and

1551 hfb
23 hrs.

RECORD

Cased in. ft.

Sand

Gas

Oil

Total Depth 3219

PRODUCTION

1st 24 hrs. Nat.

1st 24 hrs. after shot

Gas Cu. Ft.

Dry Hole

Abandoned

Date

4-17-35 192

ORVAL MANNSCHRECK

Scout