



Rice

Map No. NSA Sec. 29 Twp. 19 R. 9W


Well No. 2 Lounear Farm  
Shell Pit. Company

330 Ft. from N. Line

\_\_\_\_\_ Ft. from S. Line

\_\_\_\_\_ Ft. from E. Line

990 Ft. from W. Line

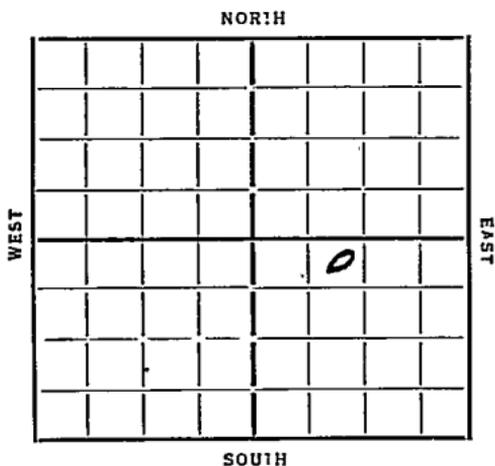

Date 1935

REPORT

1/9 Moving in  
1/17 15" 168 TD 171 WOC  
1/24 log 1725  
1/31 " 2445  
2/7 " 3112 KC 2903 S.O. 2925  
2/14 Siliceous 3217 6" 3217  
TD 3227  
2/21 TD 3226 2200' oil  
2/28 TD 3235 Est 63 Bls per H  
2/6 Siliceous 3217 TD 3235  
1325 Bls.

COMPLETED

Map No. 49 Sec. 29 Twp. 19 R. 9W

Well No. 2-Tourneau

Shell pet Company

Contractor

**FIRST REPORTS**

**SECTION PLAT**

330 Ft. from N. Line

..... Ft. from S. Line

..... Ft. from E. Line

990 Ft. from W. Line

		0	

Location.....

Rig up.....

Drilling and Remarks:

*Moving in*

**RECORD**

Cased.....in., .....ft.

Sand.....

Gas.....

Oil.....

Total Depth.....

**PRODUCTION**

1st 24 hrs. Nat.....

1st 24 hrs. after shot.....

Gas.....Cu. Ft.

Dry Hole.....

Abandoned.....

Date

1-9-35 192

**ORVAL MANNSCHRECK**

Scout

v510

Map No. 49 Sec. 29 Twp. 19 R. 9W

Well No. 2 - Tourneau

Shell petroleum Company

Contractor

**COMPLETED**


**SECTION PLAT**

330 Ft. from N. Line

..... Ft. from S. Line

..... Ft. from E. Line

990 Ft. from W. Line

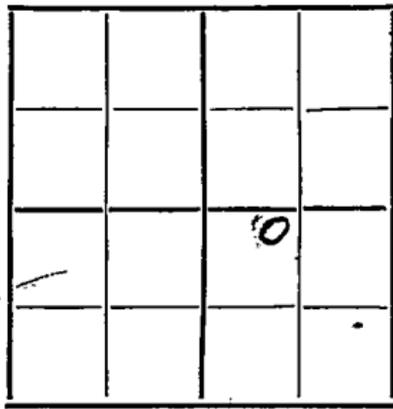

Location.....

Rig up.....

Drilling and Remarks:

1325 H<sub>2</sub>O

**RECORD**

Cased..... in., ..... ft.

Sand siliceous 3217

Gas.....

Oil.....

Total Depth 3235

**PRODUCTION**

1st 24 hrs. Nat.....

1st 24 hrs. after shot.....

Gas..... Cu. Ft.

Dry Hole.....

Abandoned.....

Date

**ORVAL MANNSCHRECK**

3-6-35 192.....

Scout