


Map No. KANSAS Sec. 29 Twp. 19 R. 9W

Well No. 4 Wallis Farm  
Sinclair-Prairie Company

*Rice*

NORTH

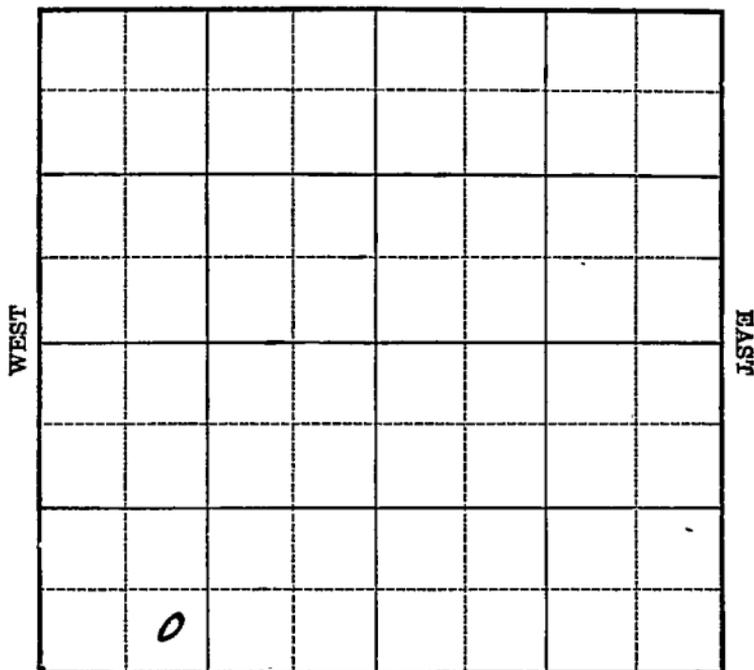

SOUTH

Location \_\_\_\_\_

Drilling Remarks \_\_\_\_\_

\_\_\_\_\_

\_\_\_\_\_

**RECORD**

Cased \_\_\_\_\_ in. \_\_\_\_\_ ft.

Sand \_\_\_\_\_

Gas \_\_\_\_\_

Oil \_\_\_\_\_

Total Depth \_\_\_\_\_

Rig Up \_\_\_\_\_

Drilling Remarks \_\_\_\_\_

\_\_\_\_\_

\_\_\_\_\_

**PRODUCTION**

1st 24 hrs. Nat. \_\_\_\_\_

1st 24 hrs. after shot \_\_\_\_\_

Gas \_\_\_\_\_ cu. ft.

Dry Hole \_\_\_\_\_

Abandoned \_\_\_\_\_



Map No. 49 Sec. 29 Twp. 19 R. 9W

Well No. 4 - Wallis

Sinclair-Prairie Company

Contractor

SECTION PLAT

**BEST REPORTS**

..... Ft. from N. Line

330 Ft. from S. Line

..... Ft. from E. Line

990 Ft. from W. Line


KANSAS

Location.....

Rig up.....

Drilling and Remarks:

*Rig*

RECORD

Cased..... in., ..... ft.

Sand.....

~~Gas~~.....

Oil.....

Total Depth.....

PRODUCTION

1st 24 hrs. Nat.....

1st 24 hrs. after shot.....

Gas..... Cu. Ft.

Dry Hole.....

Abandoned.....

Date

2-20-35 192.....

**ORVAL MANNSCHRECK**

..... Scout

Map No. 49 Sec. 29 Twp. 19 R. 9W

Well No. 4 - Willis

Sinclair Prairie Company

Contractor

**COMPLETED**

SECTION PLAT


..... Ft. from N. Line

330 Ft. from S. Line

..... Ft. from E. Line

990 Ft. from W. Line

Location .....

Rig up .....

Drilling and Remarks:

1000 and  
428 bbls

RECORD

Cased          in.,          ft.

Sand Silicums 3216

Gas .....

Oil .....

Total Depth 3241

PRODUCTION

1st 24 hrs. Nat. ....

1st 24 hrs. after shot. ....

Gas .....

Cu. Ft.

Dry Hole .....

Abandoned .....

Date

**ORVAL MANNSCHRECK**

4-10-35 192

Scout