


Map No. **KANSAS** Sec. **29** Twp. **19** R. **9W**
 Well No. **4-Tourneau** Farm
Shell Pit. Company

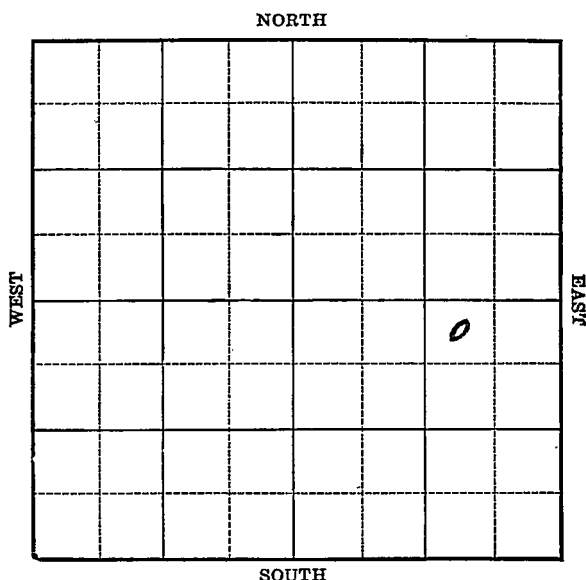

Location _____

Drilling Remarks _____

Rig Up _____

Drilling Remarks _____

RECORD

Cased _____ in. _____ ft.

Sand _____

Gas _____

Oil _____

Total Depth _____

PRODUCTION

1st 24 hrs. Nat. _____

1st 24 hrs. after shot _____

Gas _____ cu. ft.

Dry Hole _____

Abandoned _____


Map No. KANSAS Sec. 29 Twp. 19 R. 9W
Well No. 4 - Tournear Farm
Shell Pet Company

330 Ft. from N. Line

_____ Ft. from S. Line

990 Ft. from E. Line

_____ Ft. from W. Line

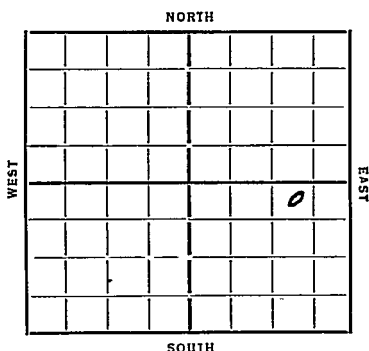

Date	REPORT
1935	
3/27	Location
4/4	Blg 120
4/14	" 985
4/18	" 2175
4/26	2985 fsg
5/2	—
5/9	Coring 3210
5/16	7" 3222 Sil 3222
5/23	3241 T1 164 Bbls 7 1/2 hrs.
	acidize
5/29	3241 T1 1000 acid
	516 Bbls May deepen
6/6	3245 T1 20 Bbls
	per hr tubing
6/12	Sil 3222 T1 3245
	516 Bbls 23 hrs

COMPLETED

Map No. 49 Sec. 29 Twp. 19 R. 9WWell No. 4-TourneauShell pet Company

Contractor

FIRST REPORT

SECTION PLAT

330 Ft. from N. Line

Ft. from S. Line

990 Ft. from E. Line

Ft. from W. Line

			0

Location ☒

Rig up

Drilling and Remarks:

RECORD

Cased.....in.,ft.

Sand.....

Gas.....

Oil.....

Total Depth.....

PRODUCTION

1st 24 hrs. Nat.....

1st 24 hrs. after shot.....

Gas.....Cu. Ft.

Dry Hole.....

Abandoned.....

Date

ORVAL MANNSCHRECK

3-27-35 192.....Scout


Contractor

COMPLETED

SECTION PLAT

330 Ft. from N. Line

Ft. from S. Line

990 Ft. from E. Line

Ft. from W. Line

			0

Location

Rig up

Drilling and Remarks:

516 lbs
23 hrs

RECORD

Cased in., ft.

Sand Sil 3222

Gas

Oil

Total Depth 3245

PRODUCTION

1st 24 hrs. Nat.

1st 24 hrs. after shot

Gas Cu. Ft.

Dry Hole

Abandoned

Date

6-12-35 192

ORVAL MANNSCHECK

Scout